


DATE 9 OCTOBER 1996

TOWN OF LEXINGTON — BOARD OF PUBLIC WORKS

SEWER DIVISION

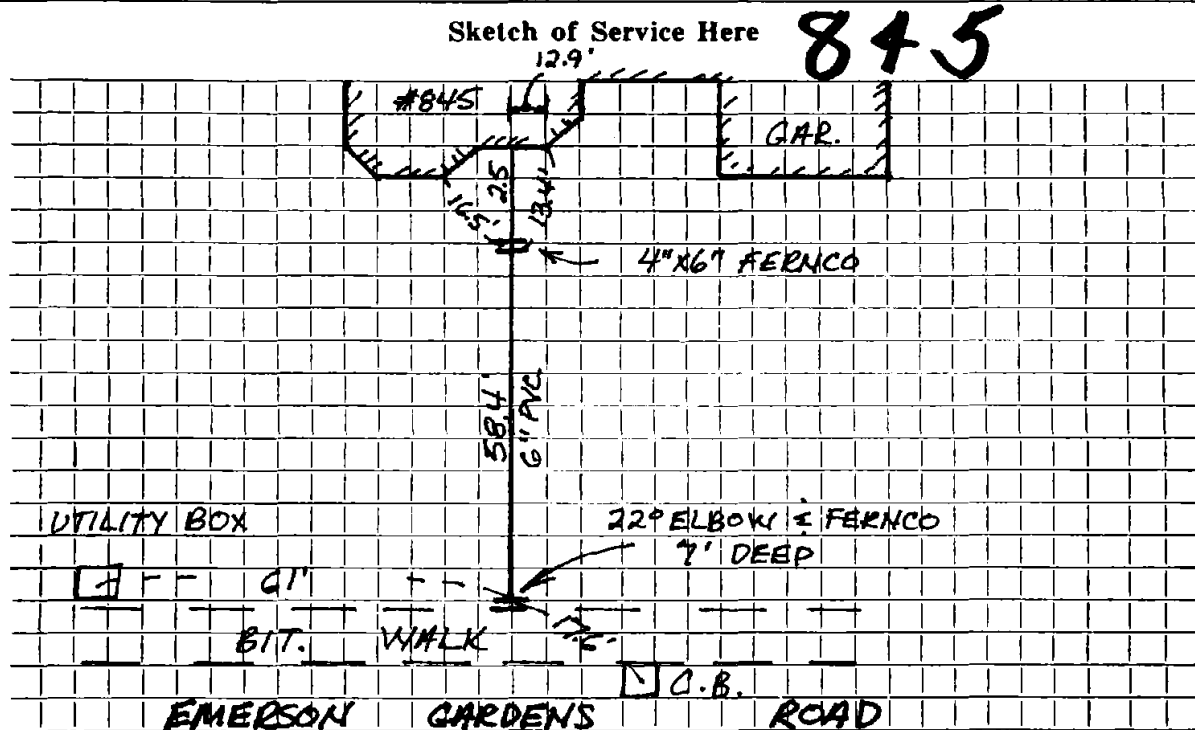

Connection made in EMERSON GARDENS RD. Street.

Work completed J.M. MCLAUGHLIN

Remarks: