




DATE \_\_\_\_\_

TOWN OF LEXINGTON — BOARD OF PUBLIC WORKS

SEWER DIVISION

Sketch of Service Here **847**

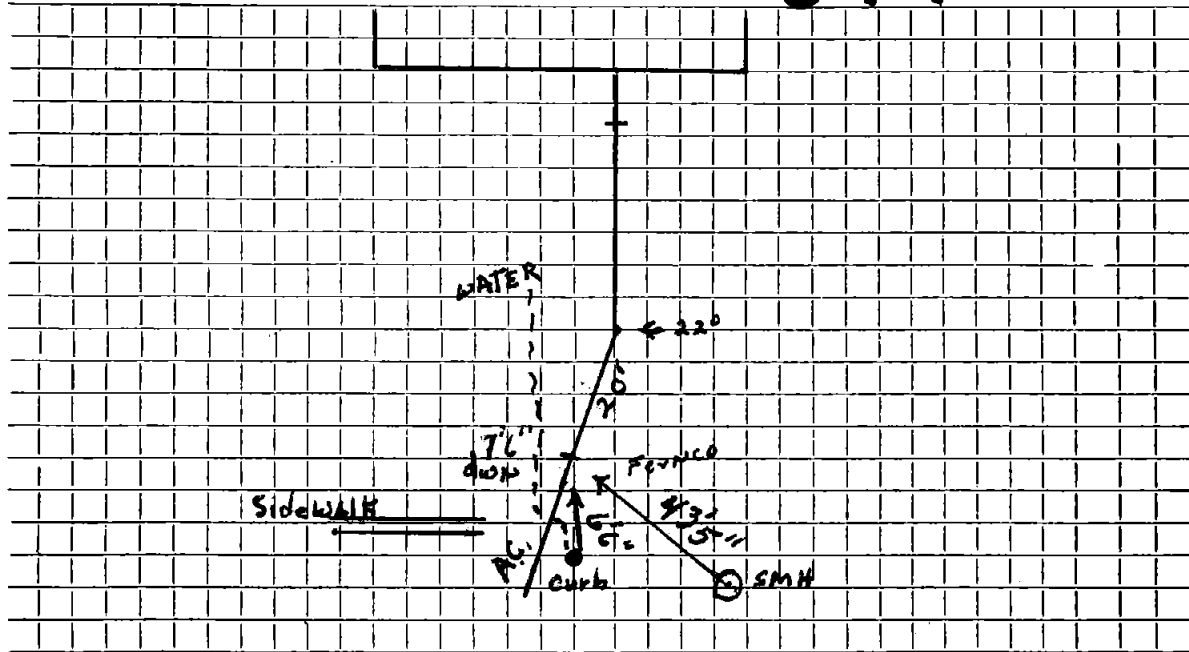

Connection made in ..... Street. Work completed .....

Remarks: .....

.....

.....