

Name David Eagle

Service No.

Address 155 Emerson Rd. Lexington, Mass.

Location

Kind of Pipe

Size

Size of Main

Repair—Renewal—New Service Dave Eagle #2794

Location


Date	Material	Amount	Total	Date	Amount
12/14/75	41' 6" Transite Pipe				
	10' 4" Cast Iron Pipe				

DATE _____

TOWN OF LEXINGTON — BOARD OF PUBLIC WORKS
SEWER DIVISION

Sketch of Service Here

155

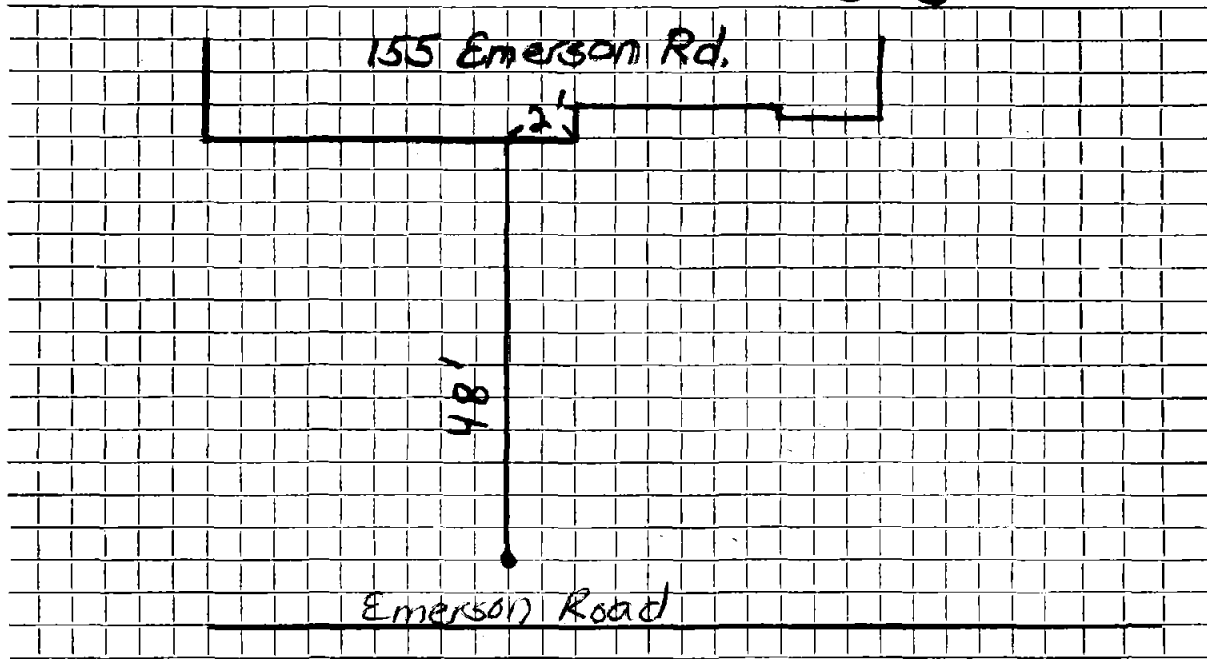

Connection made in ... EMERSON ROAD ... Street.

Work completed ... 12-18-75

Remarks:
.....
.....