

Name Busa Realty Trust

Service No.

Address 252 Emerson Road

Location

Kind of Pipe

Size

Size of Main

Repair—Renewal—New Service DeFlice #1860

Location


Date		Material	Amount	Total	Date	Amount
5-24-71	32'	6" Transite pipe				
	10'	4" Cast Iron pipe				
					11-1-68	
					51' 6" Transite	

DATE _____

TOWN OF LEXINGTON — BOARD OF PUBLIC WORKS

SEWER DIVISION

Sketch of Service Here **252**

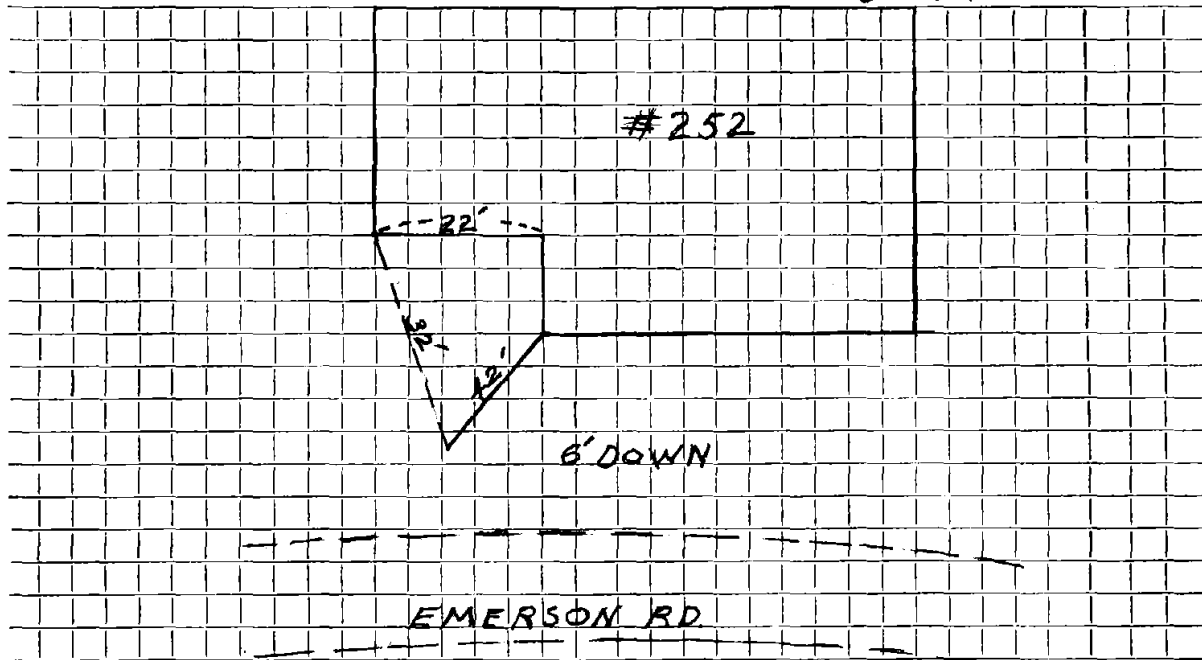

Connection made in Street. Work completed

Remarks:
.....
.....