

Name Busa Realty Trust

Service No.

Address 254 EMERSON Rd.

Location

Kind of Pipe

Size

Size of Main

Repair—Renewal—New Service DeFlice #2131

Location


Date		Material	Amount	Total	Date		Amount
7-27-72	35'	6" Transite pipe					
	10'	4" Cast Iron pipe					
					11-1-	68	
						45' 6" Transite	

DATE \_\_\_\_\_

TOWN OF LEXINGTON — BOARD OF PUBLIC WORKS  
SEWER DIVISION

Sketch of Service Here

**254**

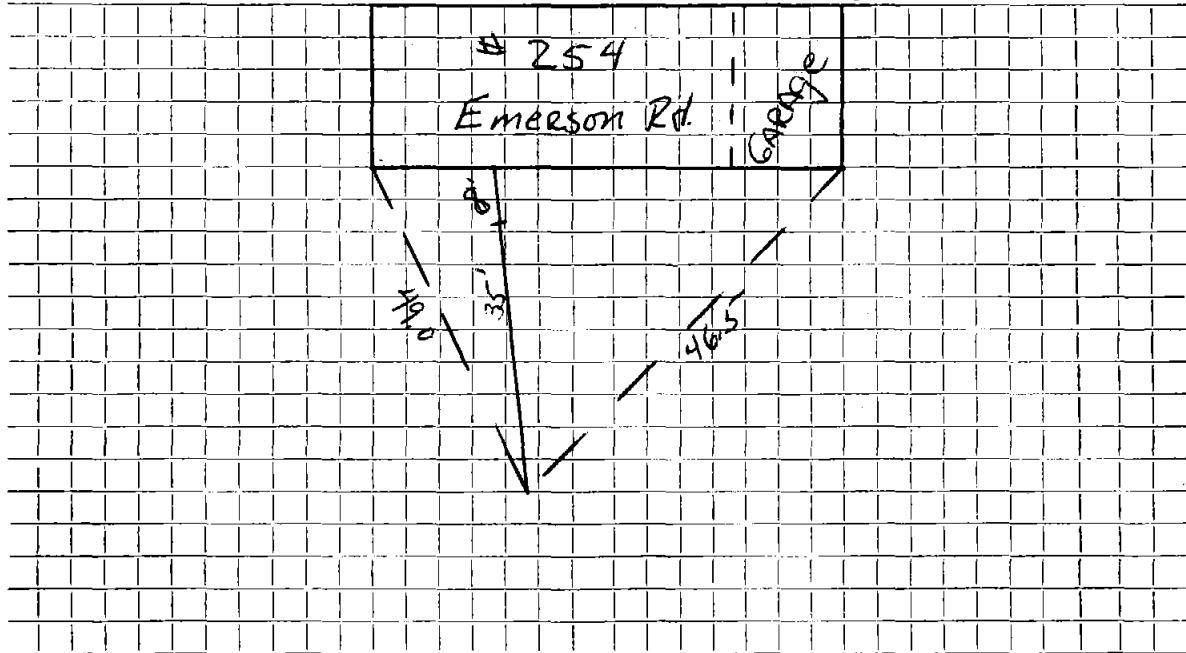

Connection made in ..... Street. Work completed .....

Remarks: .....  
.....  
.....