

Name Busa Realty Trust

Service No.

Address 256 Emerson Road

Location

Kind of Pipe

Size

Size of Main

Repair—Renewal—New Service DeFlice #1906

Location

Date		Material	Amount		Total		Date		Amount
9-9-71	31'	6" Transite pipe							
	10'	4" Cast Iron pipe							
							11-1-68		
							48' 6" Transite		


DATE _____

TOWN OF LEXINGTON — BOARD OF PUBLIC WORKS

SEWER DIVISION

Sketch of Service Here

256

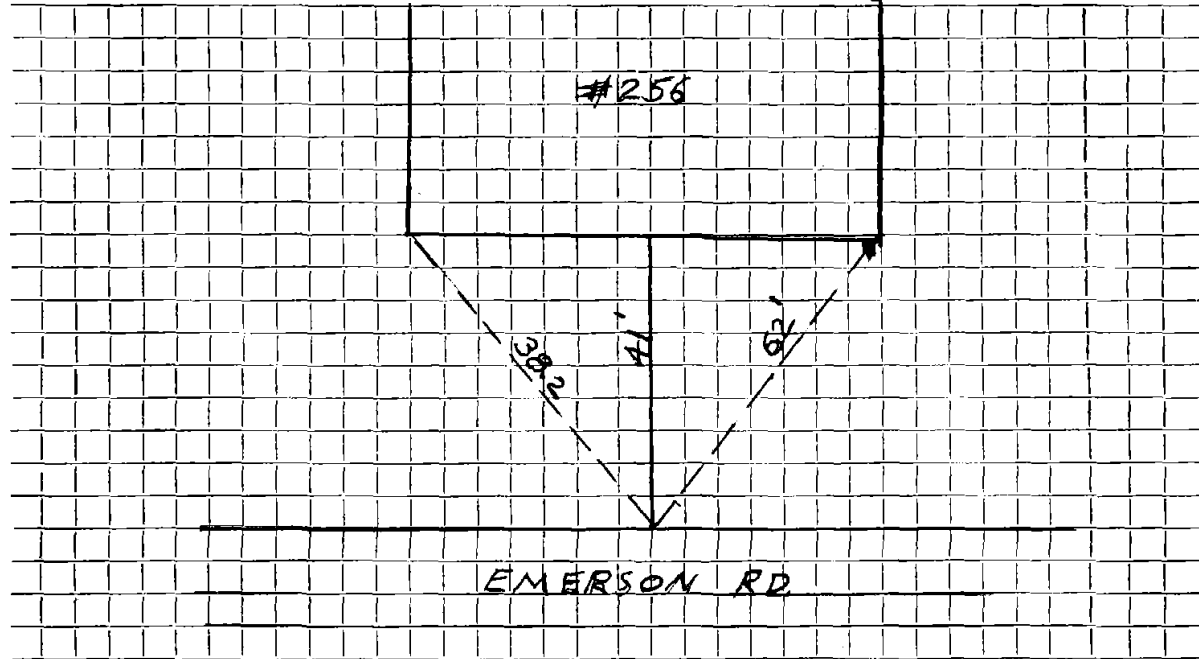

Connection made in Street. Work completed

Remarks:
.....
.....