


DATE _____

TOWN OF LEXINGTON — BOARD OF PUBLIC WORKS

SEWER DIVISION

Sketch of Service Here

273

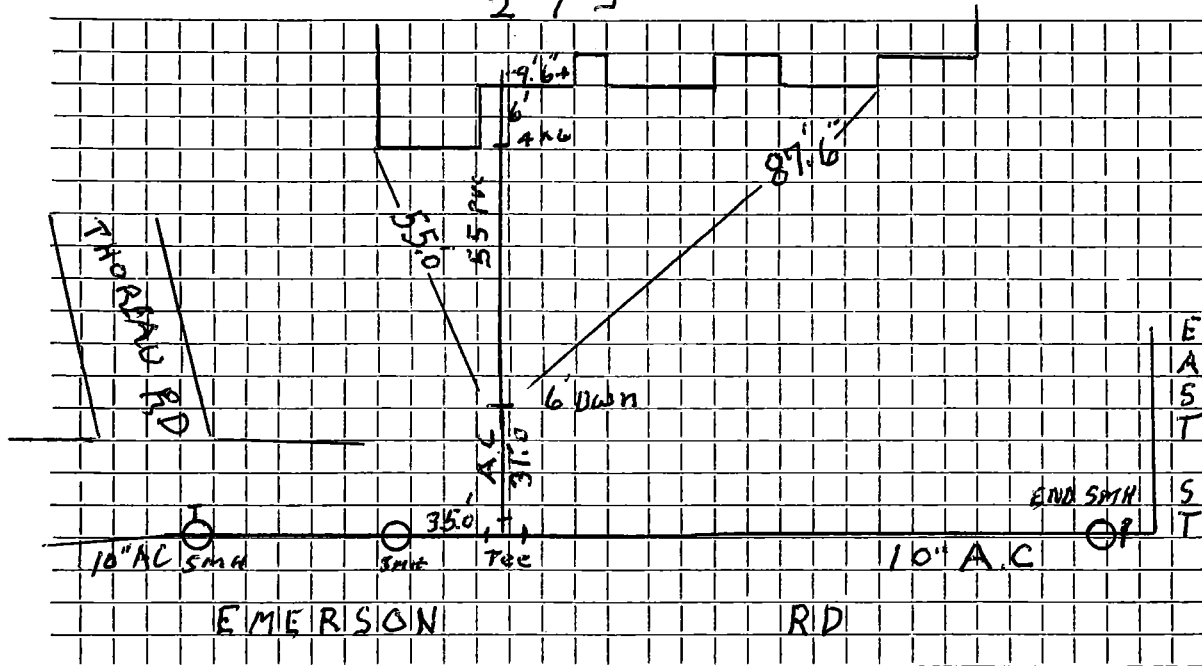

Connection made in Street. Work completed 10/10/09

Remarks: Jim McLau