

Name Jay G. Levinthal

Service No. 17

Address # 279 Emerson Road

Location

Kind of Pipe

Size

Size of Main

Repair—Renewal—New Service

Valeri #2618

Location AUG 16 1976


Date	Material	Amount	Total	Date	Amount
Oct. '67	31' 6" Transite Pipe	@6.00	186.00	4-1-75	Deposit
19/75	105' 6" Transite Pipe				
	10' 4" Cast Iron Pipe				
				10- - 67	
					31' 6" Transite

DATE _____

TOWN OF LEXINGTON — BOARD OF PUBLIC WORKS

SEWER DIVISION

Sketch of Service Here **279**

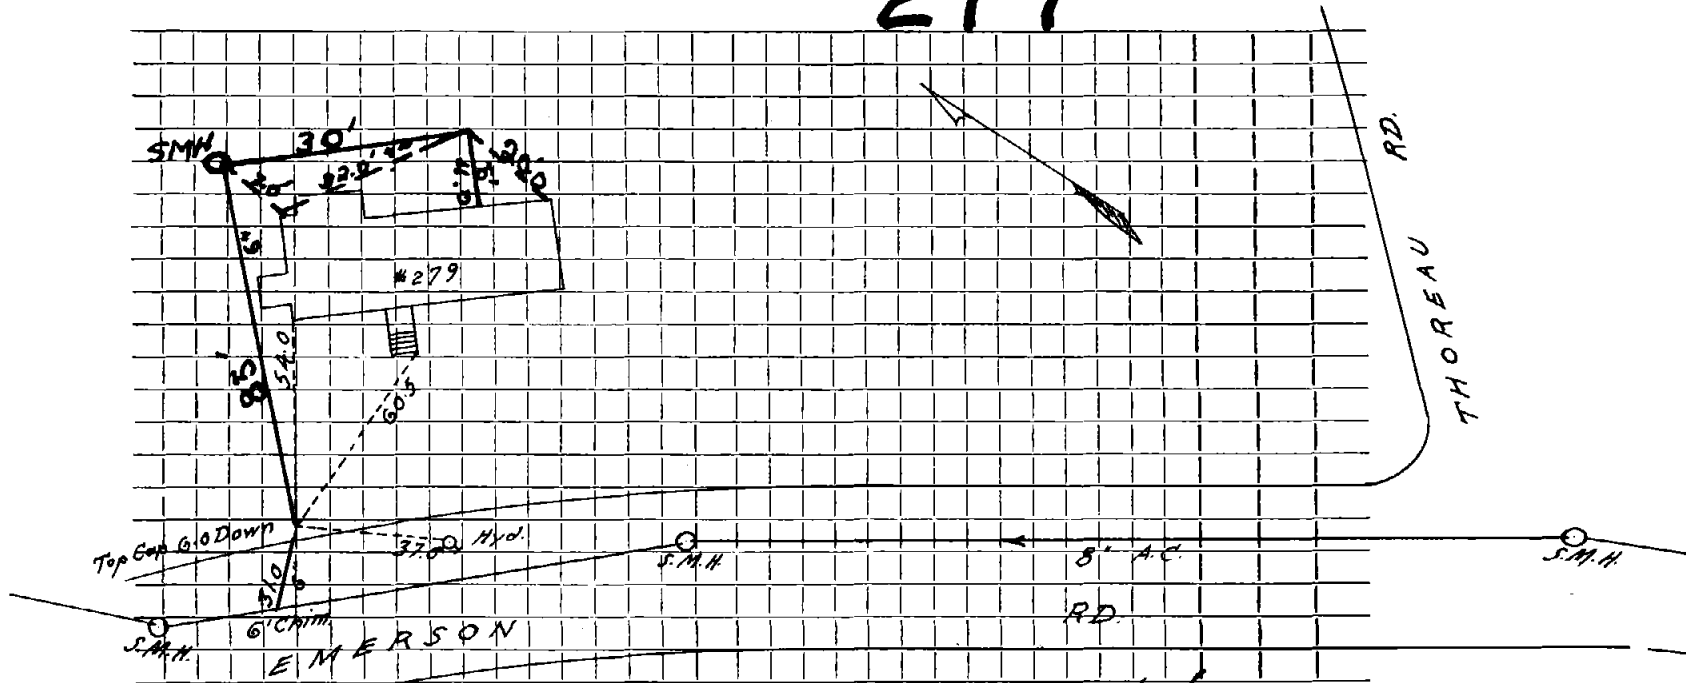

Connection made in 279 Emerson St. Street.

Work completed 4/9/75

Remarks:
.....
.....