


DATE _____

TOWN OF LEXINGTON — BOARD OF PUBLIC WORKS SEWER DIVISION

BURNHAM RD.

Sketch of Service Here **285**

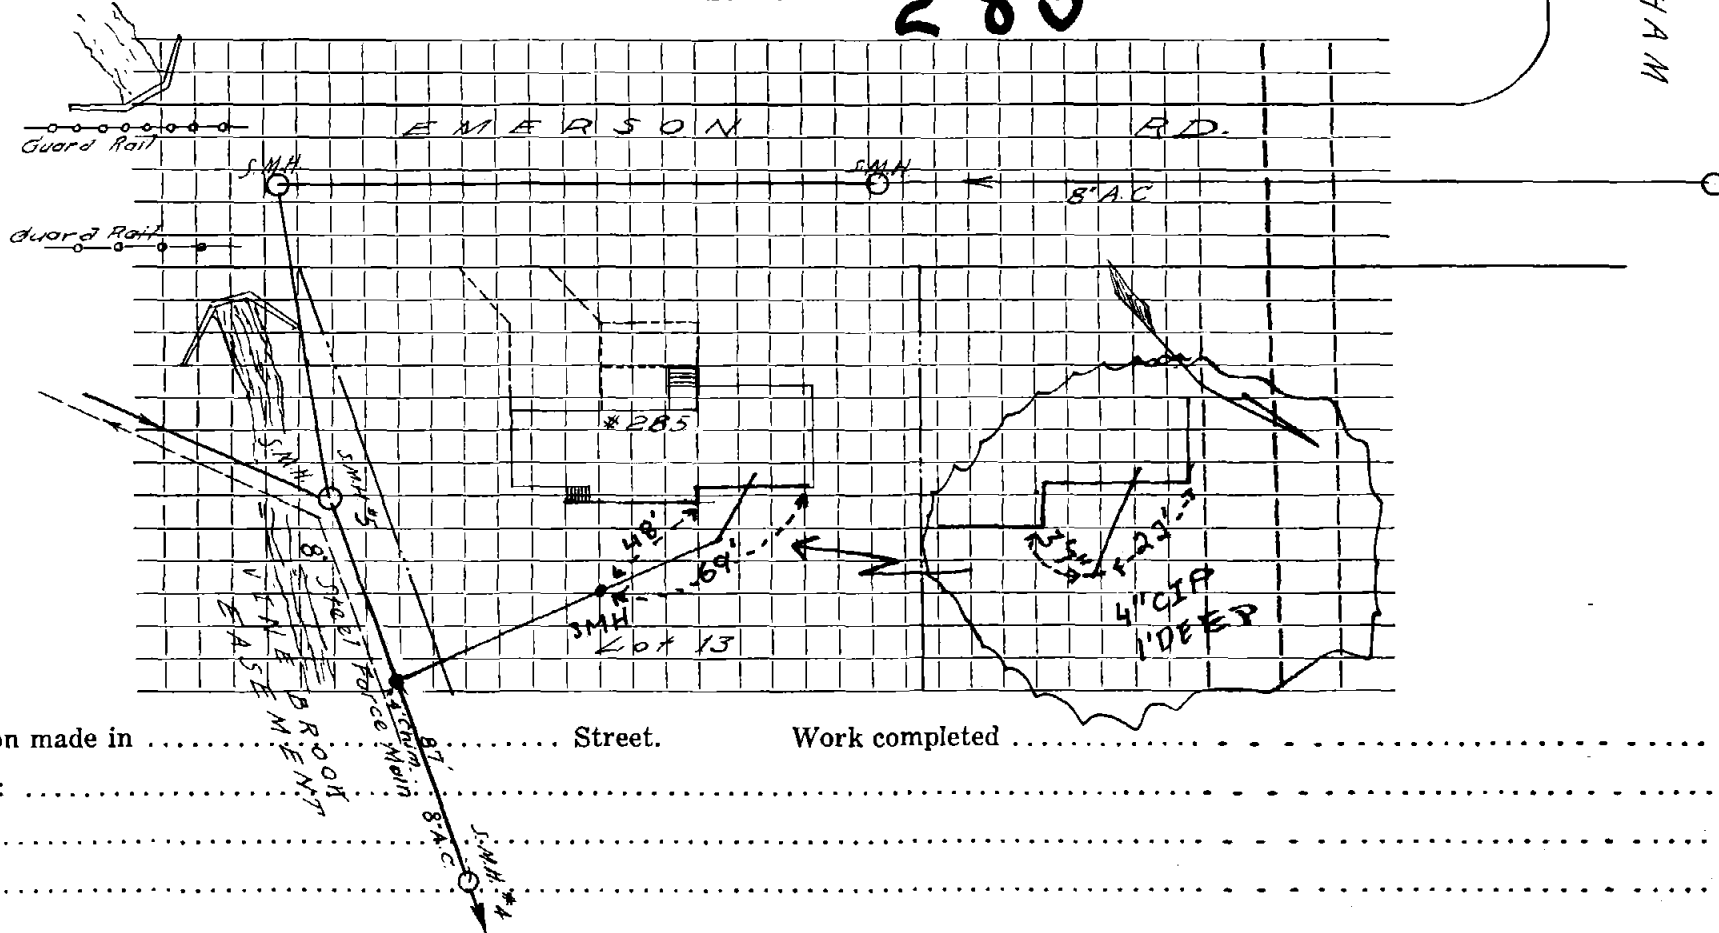

Connection made in Street. Work completed

Remarks:
.....
.....