

Name Daniel Margarian

Service No. 116

Address 286 Emers on Road

Location

Kind of Pipe

Size

Size of Main

Repair—Renewal—New Service Aldo #803

Location Conn 10-30-64


Date		Material	Amount			Total		Date		Amount
Oct 165	35'	6" Transite pipe @	.00	210	.00	210	.00	9-18-67	<i>Deposit</i>	210 00
9-67	109'	6" Transite pipe								
								10- - 65		
								35' 6" Transite		

DATE _____

TOWN OF LEXINGTON — BOARD OF PUBLIC WORKS

SEWER DIVISION

Sketch of Service Here **286**

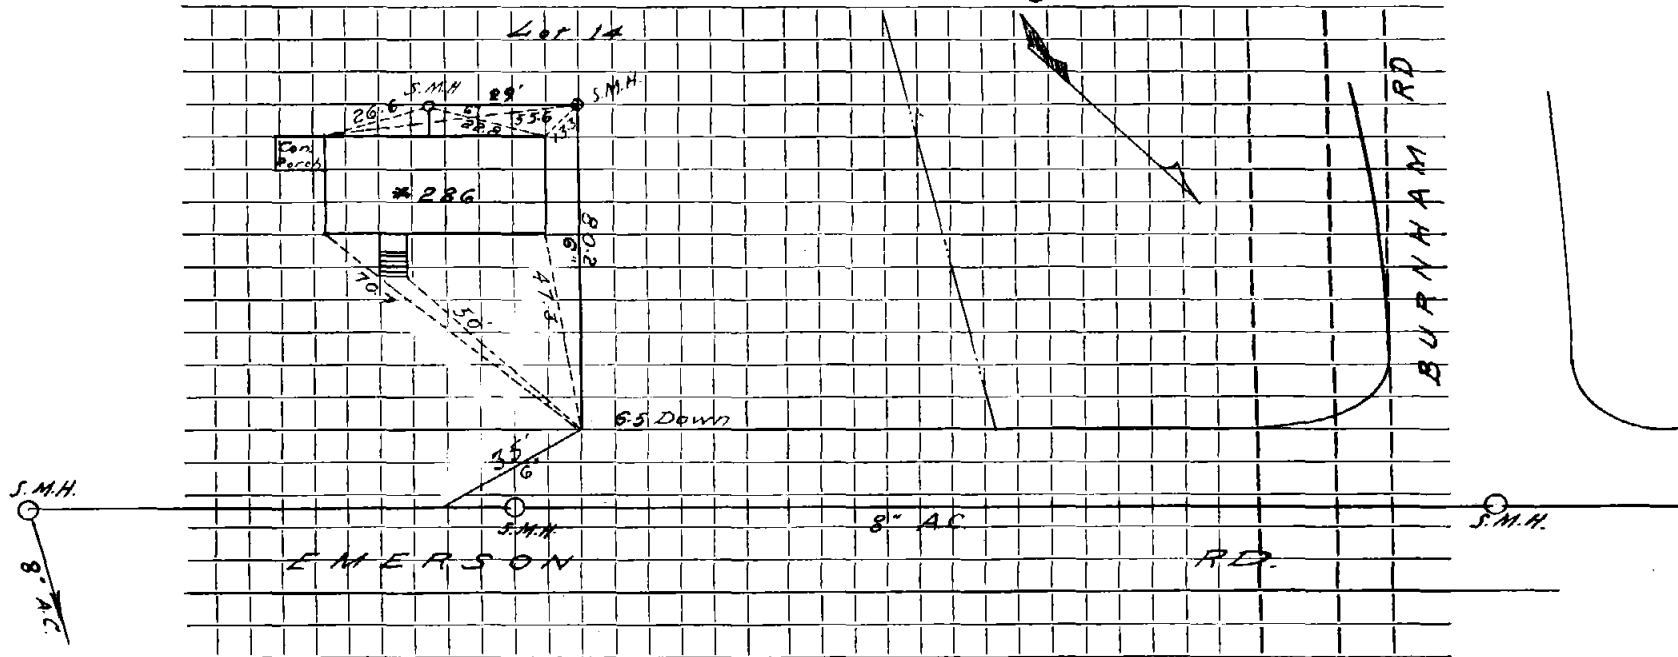

Connection made in Street. Work completed

Remarks:

.....

.....