

Name Val J. Krukonis

Service No. 120

Address # 287 Emerson Road

Location

FEB 12 1973

Kind of Pipe

Size

Size of Main

Repair—Renewal—**New Service**

Valeri #2142

Location


Date		Material	Amount	Total	Date	Amount
Oct. '67	38'	6" Transite pipe @ 6.00		228.00	8/25/72	Deposit 228.00
1/29/72	112'	6" Transite				
	7'	4" Cast Iron			11- - 67	
					38' 6" Transite	
					3-24-98	Plugged at M H on corner of house
					6-28-99	SAME spot

DATE _____

TOWN OF LEXINGTON — BOARD OF PUBLIC WORKS
SEWER DIVISION

Sketch of Service Here

287

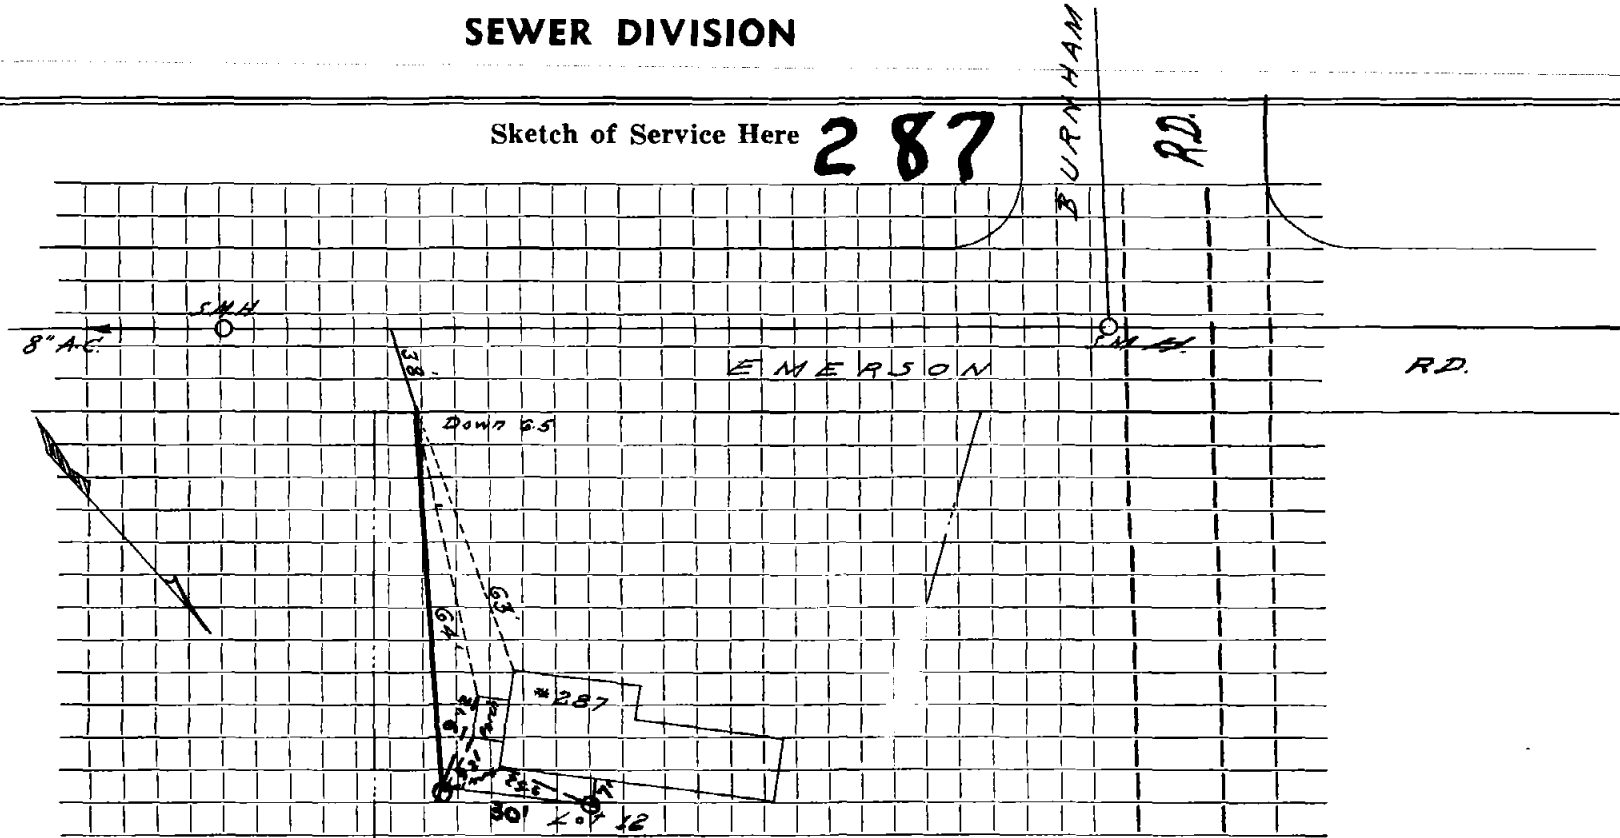

Connection made in Street. Work completed

Remarks:

.....

.....