

Name Anthony Iandoli

Service No. 158

Address # 289 Emerson Road

38 Emerson Rd

Location

Kind of Pipe

Size

Size of Main

Repair—Renewal—New Service Ferrari Plumbing #852


Location MAR 18 1968

Date	Material	Amount	Total	Date	Amount
Oct. '67	36' 6" Transite pipe @ 6.00		216.00		
-15-67	28' 4" Cast Iron Pipe				
				10- - 67	
				36' 6" Transite	

DATE _____

TOWN OF LEXINGTON — BOARD OF PUBLIC WORKS

SEWER DIVISION

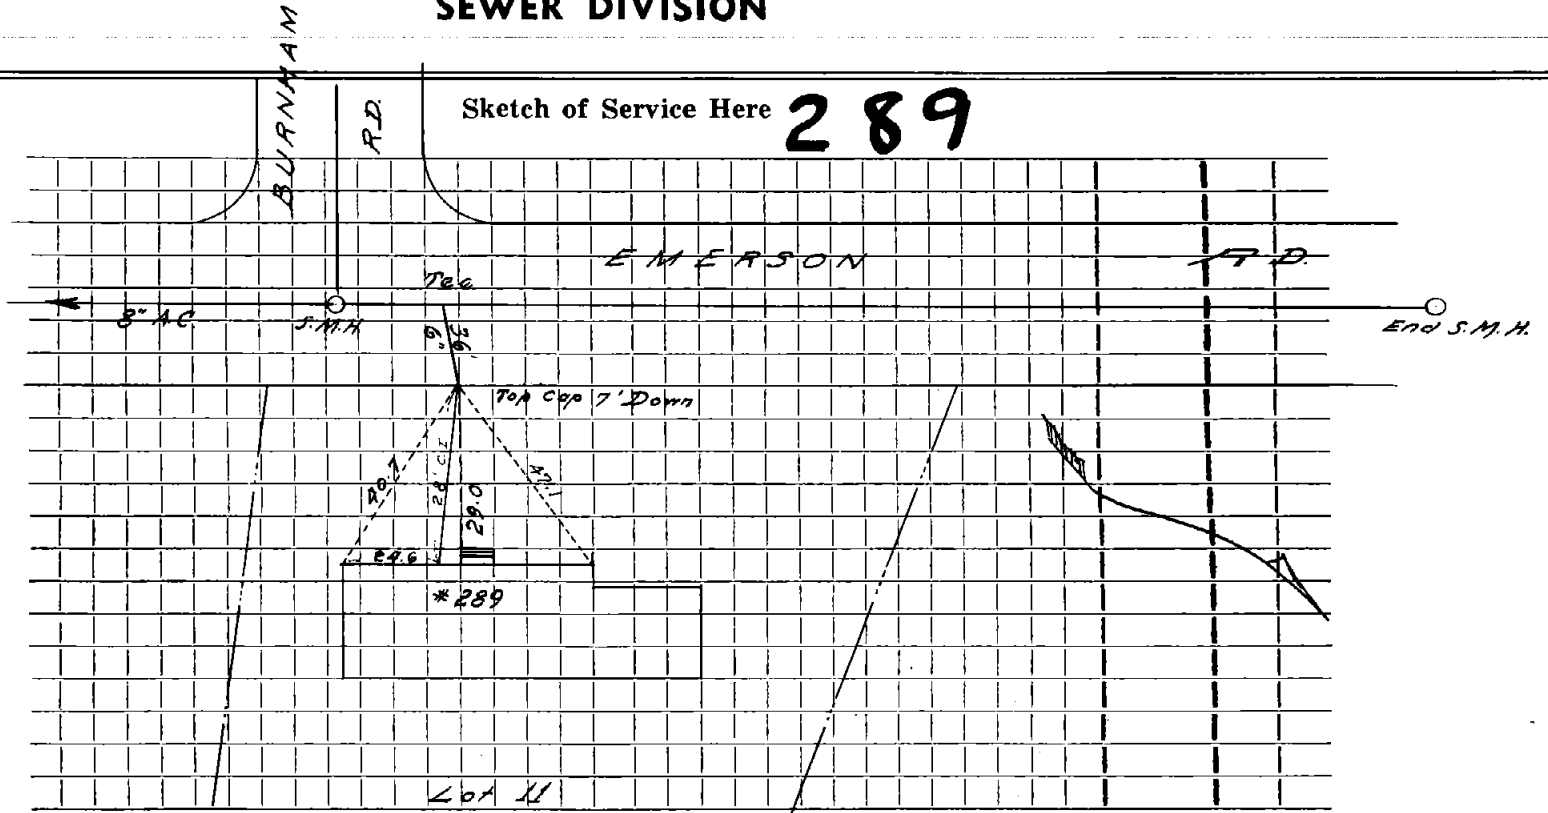

Connection made in Street. Work completed

Remarks:

.....

.....