

Name John H. Cawley

Service No. 100

Address # 290 Emerson Road

Emerson Rd.

Location

Kind of Pipe

Size

Size of Main

Repair—Renewal—New Service Valeri #1462

Location DEC 22 1969

Date	Material	Amount	Total	Date	Amount
Oct. 16 27	6" Transite pipe @6.00		162.00	9-17-69	<i>Deposit</i>
-17-69	134' 6" Transite pipe				162.00
	10' 4" Cast Iron pipe			10- - 67	
				27	6" Transite


DATE _____

TOWN OF LEXINGTON — BOARD OF PUBLIC WORKS

SEWER DIVISION

290 Sketch of Service Here

Lot 6

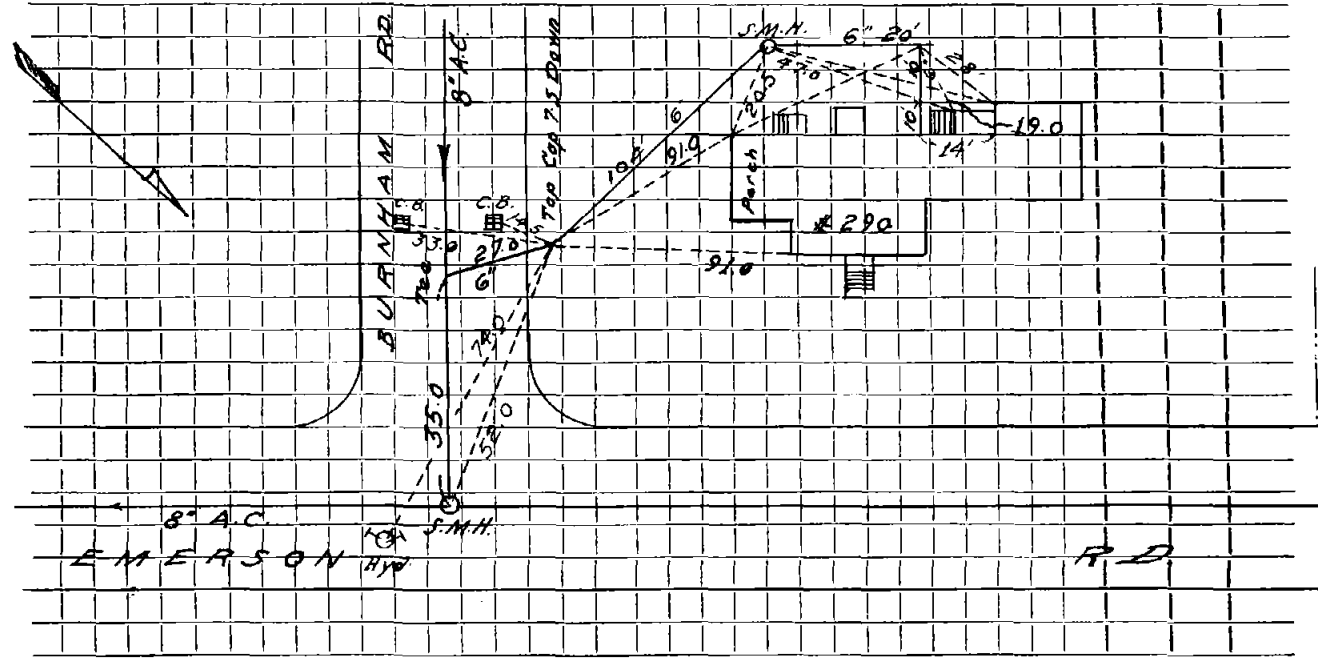

End S.M.H.

Connection made in Street. Work completed

Remarks:
.....
.....