

Name ~~Essex Street, Newark~~

Service No.

Address 292 Emerson Road

Lot 6A

Location

Kind of Pipe

Size

Size of Main

Repair—Renewal—New Service


Location

Date	Material	Amount	Total	Date	Amount
Oct. '67	37' 6" Transite pipe @6.00		222.00		
				10- -67	
				37' 6" Transite	

DATE _____

TOWN OF LEXINGTON — BOARD OF PUBLIC WORKS
SEWER DIVISION

Sketch of Service Here

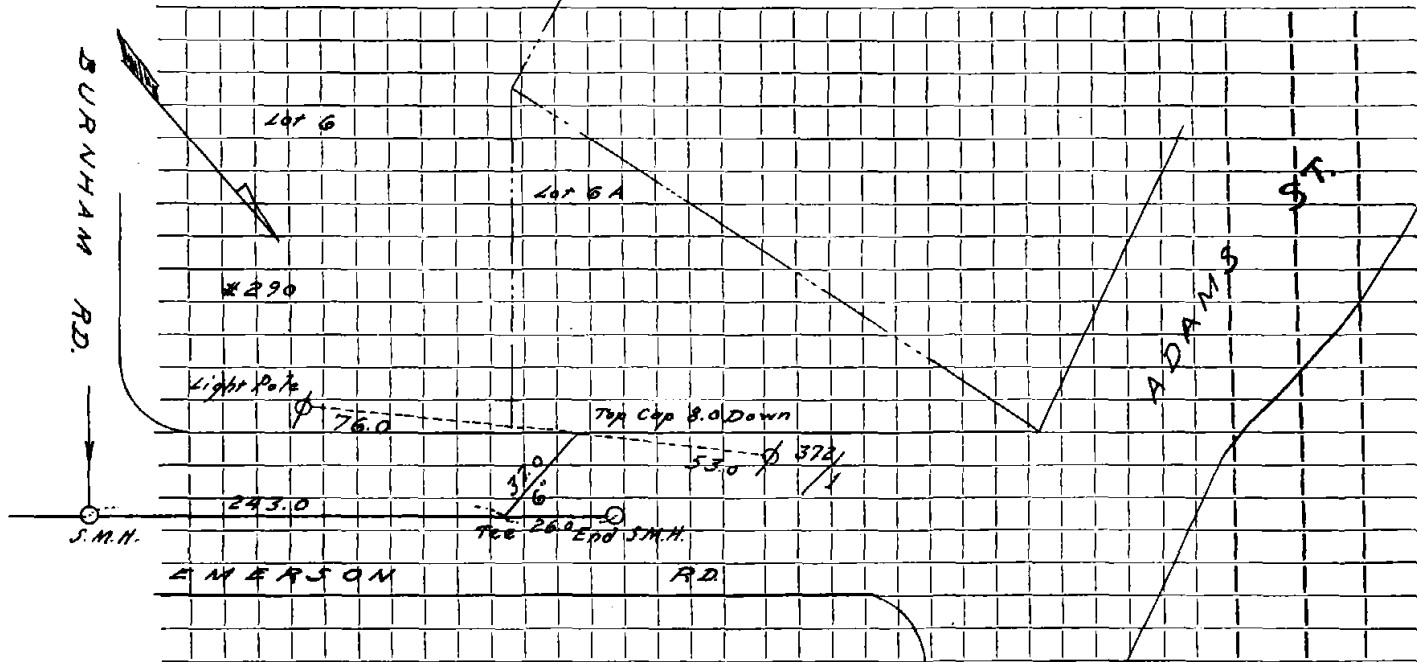

Connection made in Street. Work completed

Remarks:

.....
.....