

Name EMERSON GARDENS

Service No.

Address 39-51 EMERSON RD.

Location

Kind of Pipe

Size

Size of Main

Repair—Renewal—New Service Perino Excavating #4828

Location

Date

Material

Amount

Total

Date

Amount

9/22/89 48' of 8" PVC

9-22-89


48' 8" P.V.C.

DATE \_\_\_\_\_

# TOWN OF LEXINGTON — BOARD OF PUBLIC WORKS

## SEWER DIVISION

Sketch of Service Here

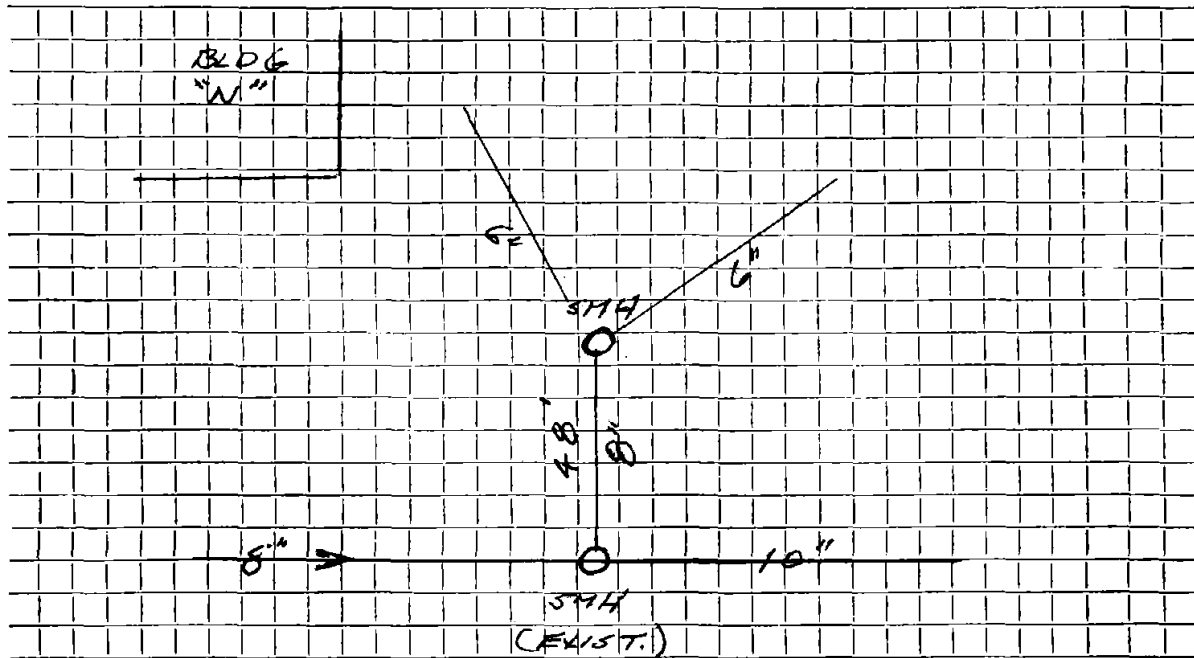

Connection made in EMERSON RD. Street. Work completed .....

Remarks: NEW SERV. @ EMERSON GARDENS .....