

Name Benjamin Franklin Homes Inc.

Service No.

Address 352 Emerson Road

Location

Kind of Pipe

Size

Size of Main

Repair—Renewal—New Service Richard Stevens Permit #364 & #486


Location

Date	Material	Amount	Total	Date	Amount
<del>24-65</del>	<del>41' 6" Transite pipe</del>				
30-65	60' 6" Transite pipe				
				6-24-65	
				41' 6" Transite	

DATE \_\_\_\_\_

TOWN OF LEXINGTON — BOARD OF PUBLIC WORKS

SEWER DIVISION

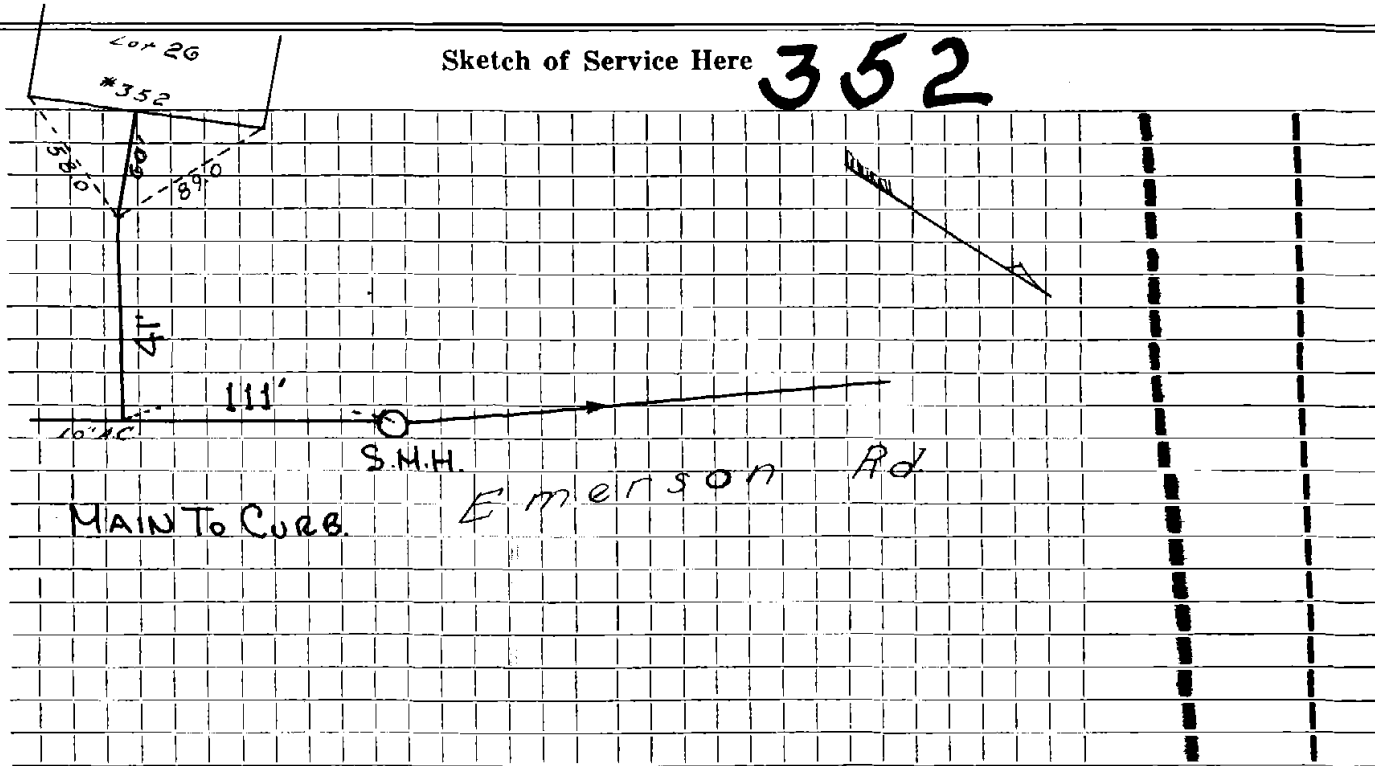

Connection made in ..... Street. Work completed .....

Remarks: .....

.....

.....