

Name Benjamin Franklin Homes

Service No. /

Address 355 Emerson Road

Lot. 29 Sta. 11+97

Location

Kind of Pipe

Size

Size of Main

~~Repair/Remove~~ — New Service John Devine - Permit #204

Location FEB 18 1965


Date	Material	Amount	Total	Date	Amount
9-12-62	Labor	38.94		1-7-65	Deposit 27.80
	10% O. H.	3.89	42.83		
	34' 6" Transite pipe @.82		27.88		
	1 11 1/4" Transite Bend		4.09	9-12-62	
	1 hr. Trucking @3.00		3.00		34' 6" Transite
	BILL WHEN CONNECTED		77.80		1 6"-11 1/4" Bend
1-1-65	74' 6" Transite pipe				

DATE _____

TOWN OF LEXINGTON — BOARD OF PUBLIC WORKS
SEWER DIVISION

Sketch of Service Here

355

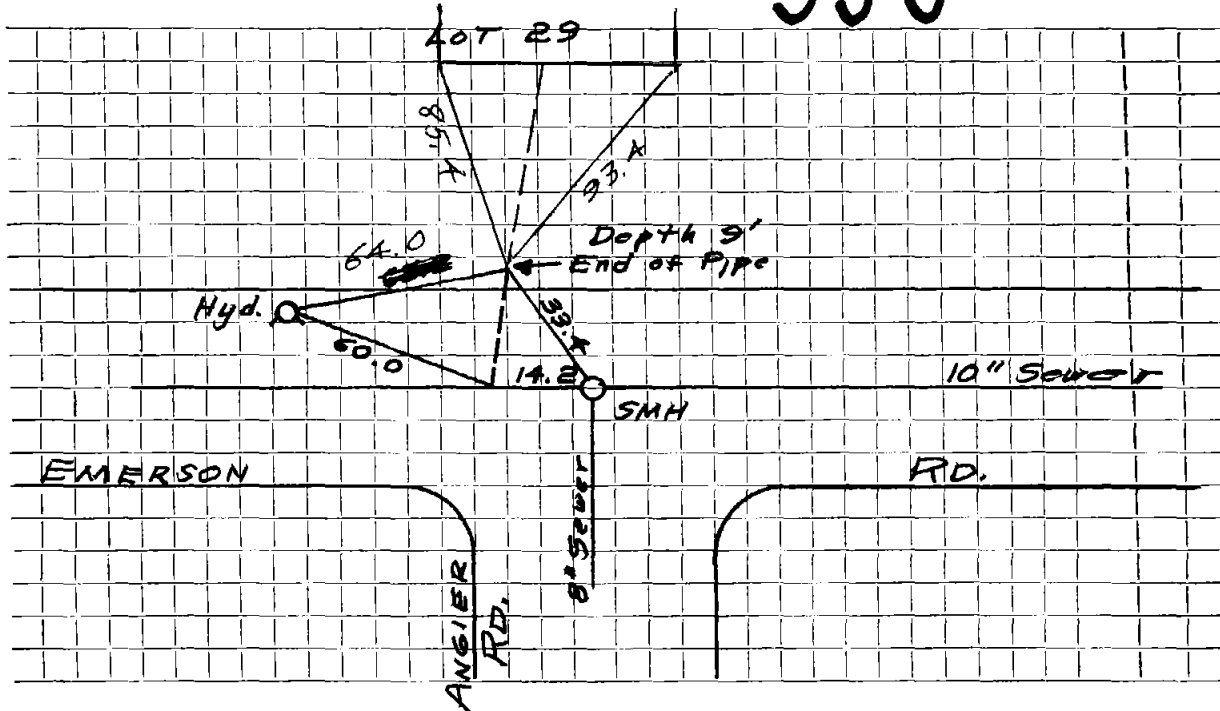

Connection made in Street. Work completed

Remarks:

.....

.....