

Name Benjamin Franklin Homes, Inc.

Service No. #85

Address 358 Emerson Road

Lot 20

Location

Kind of Pipe

Size

Size of Main

~~Repair/Removal~~ — New Service W.O. #7368

Location Comm 10-29-62


Date	Material	Amount	Total	Date	Amount
6-22-62	Labor	115.84		6-29-62	Deposit 175.00
6-23-62	"	105.84	221.68	10-29-62	Paid by W.H.C. #79 8.18
	10% O.H.	22.17	243.85	11-5-62	162.26
	100' 6" Transite pipe @82		82.00		<u>345.44</u>
	1 6X6 Transite Tee		4.09		
	3 Hrs. Trucking @3.00		9.00		
	1 Hr. Town Shovel @6.50		6.50		
			345.44		

DATE _____

TOWN OF LEXINGTON — BOARD OF PUBLIC WORKS

SEWER DIVISION

Sketch of Service Here

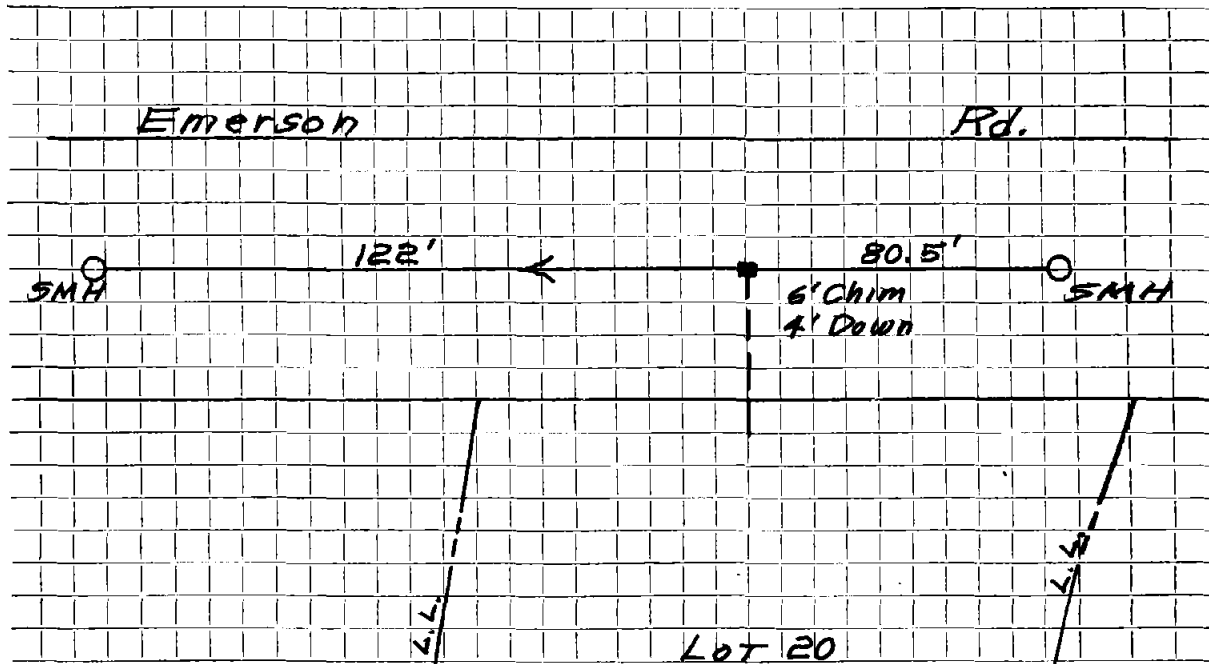

Connection made in Street. Work completed

Remarks:
.....
.....