

Name Ben Franklin Homes

Service No. 176

Address 361 Emerson Road

Lot #32 Sta. 7+28

Location

Kind of Pipe

Size

Size of Main

~~Repair or Renewal~~ — New Service

J.M. Lucente Co. Permit #144

Location DEC 23 1964

Date	Material	Amount	Total	Date	Amount
<del>9-13-62</del>	Labor	15.47		<del>10-29-64</del>	130.65
9-14-62	"	58.67	74.14		
	10% C.H.	7.41	81.55		
	<del>44' 6" Transite pipe @.82</del>		36.08	9-13-62	
	1 <del>22<sup>1</sup>/<sub>2</sub>" Transite bend</del>		4.09	44' 6" Transite	
	1 6" Transite End Cap		1.93	1 6"-22 <sup>1</sup> / <sub>2</sub> " Bend	
	1 hr. Trucking @3.00		3.00		
	4 hrs. Pumping @1.00		4.00		
	BILL WHEN CONNECTED?		130.65		
11-30-64	108' 6" Transite Pipe				


DATE \_\_\_\_\_

TOWN OF LEXINGTON — BOARD OF PUBLIC WORKS

SEWER DIVISION

Sketch of Service Here

LOT 32

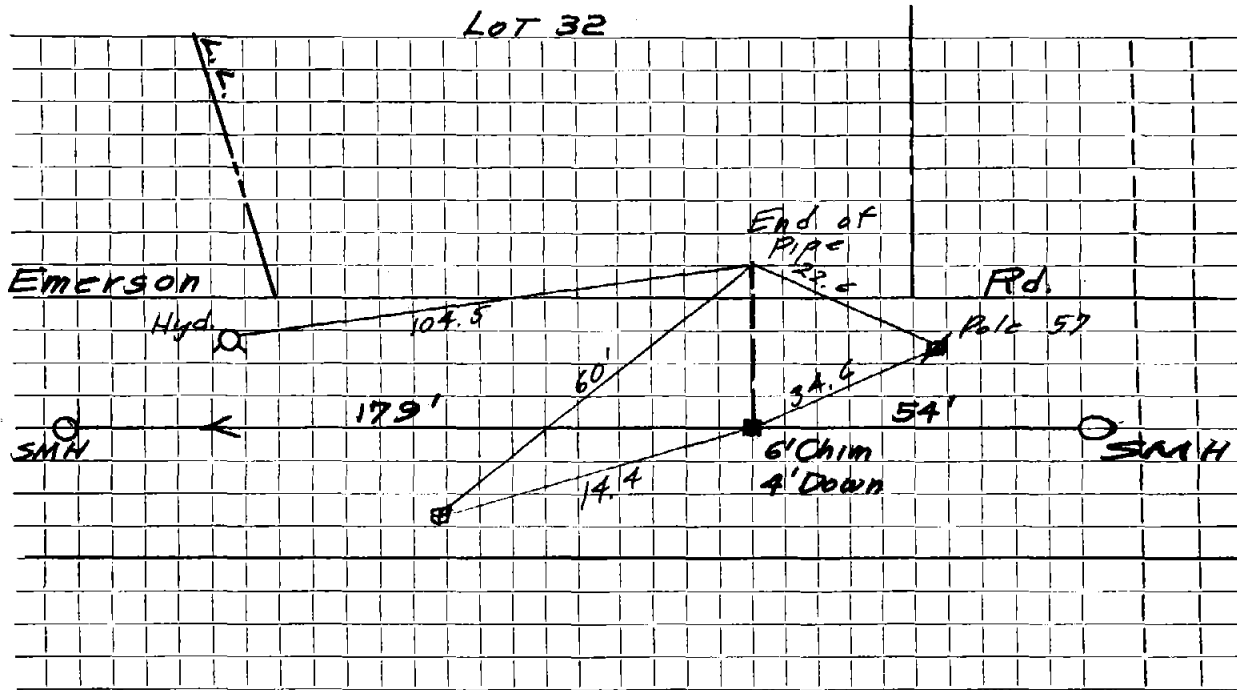

Connection made in ..... Street. Work completed .....

Remarks: .....  
.....  
.....