

Name Benjamin Franklin Homes

Service No. 87

Address 362 Emerson Road

Lot #38

Location

Kind of Pipe

Size

Size of Main

~~Repair Renewal~~ New Service

W.O. #7370

Location *Cam 10-29-62*


Date	Material	Amount	Total	Date	Amount	
<del>6-28-62</del>	Labor	47.75		6-19-62	Deposit	175.00
	10% O.H.	4.78	52.53	10-29-62	Paid by W.H. # 81	12.18
	<del>26' 6" Transite pipe @.82</del>		21.32	11-5-62		54.43
	4 1/2 ton 3/4" Stone @1.50		6.38	6-28-62		241.61
	<del>1 6 x 10 Transite Nipple</del>		1.65		26' 6" Transite	
	<del>1 90° Transite Elbow</del>		4.09		1 6" x 10" Nipple	
	2 hrs. Trucking @3.00		6.00		1 6"-90° Elbow	
	4 hrs. Pumping @1.00		4.00			
	1 hr. Compressor @3.00		3.00			
	BILL WHEN CONNECTED		98.97			
7-3-62	Labor	65.08				
	10% O.H.	6.51	71.59			
	78' 6" Transite pipe @.82		63.96			
	1 11 1/2° Transite Bend		4.09			
	1 hr. Trucking @3.00		3.00			
			241.61			

DATE \_\_\_\_\_

TOWN OF LEXINGTON — BOARD OF PUBLIC WORKS

SEWER DIVISION

Sketch of Service Here

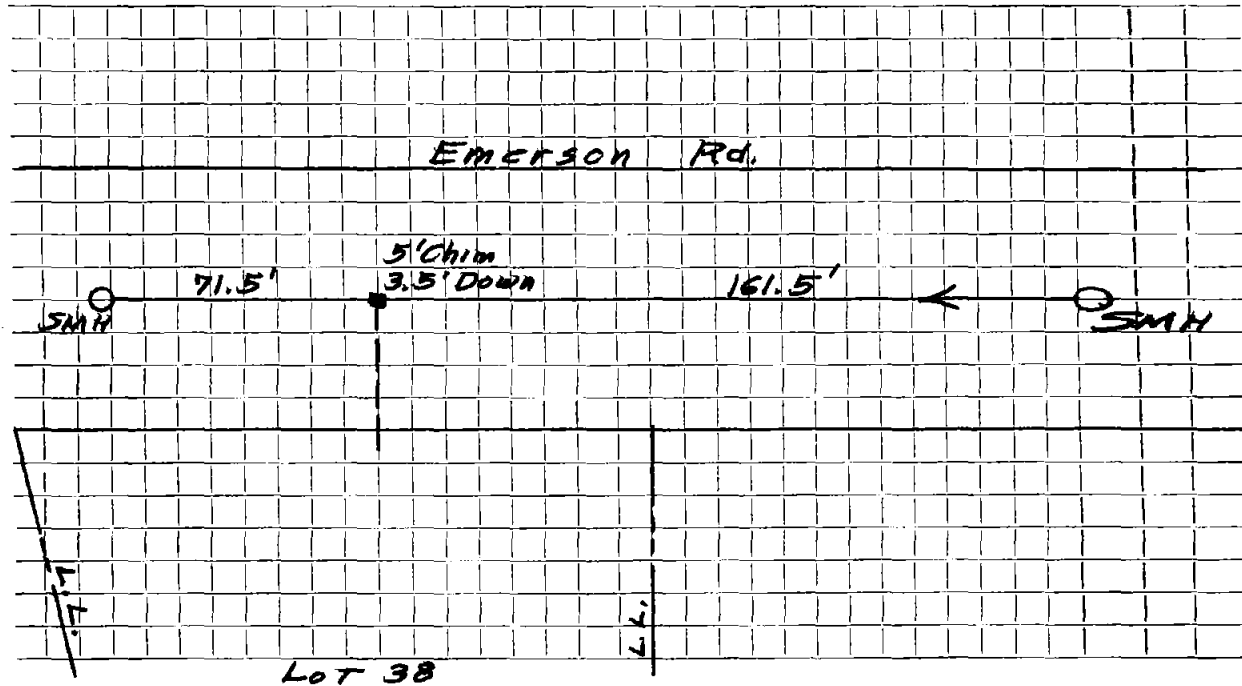

Connection made in ..... Street. Work completed .....

Remarks: .....  
.....  
.....