

Name Benjamin Franklin Homes

Service No. 177

Address 363 Emerson Road

Lot 33 Sta. 5+48

Location

Kind of Pipe

Size

Size of Main

~~Repair/Remove~~ **New Service** J.M. Lucenet Co. - Permit #145


Location DEC 28 1964

Date	Material	Amount	Total	Date	Amount
<del>9-11-62</del>	Labor	34.19		<del>10-29-64</del>	79.43
	10% O.H.	3.42	37.61		
	<del>40' 6" Transite pipe @.82</del>		<del>32.80</del>		
	<del>1 90° Transite Elbow</del>		<del>4.09</del>	9-11-62	
	1 6" Transite End Cap		1.93		40' 6" Transite
	1 hr. Trucking @3.00		<u>3.00</u>		1 6"-90° Elbow
	BILL WHEN CONNECTED		79.43		
11-16-64	25' 6" Transite pipe				

DATE \_\_\_\_\_

TOWN OF LEXINGTON — BOARD OF PUBLIC WORKS  
SEWER DIVISION

Sketch of Service Here **363**

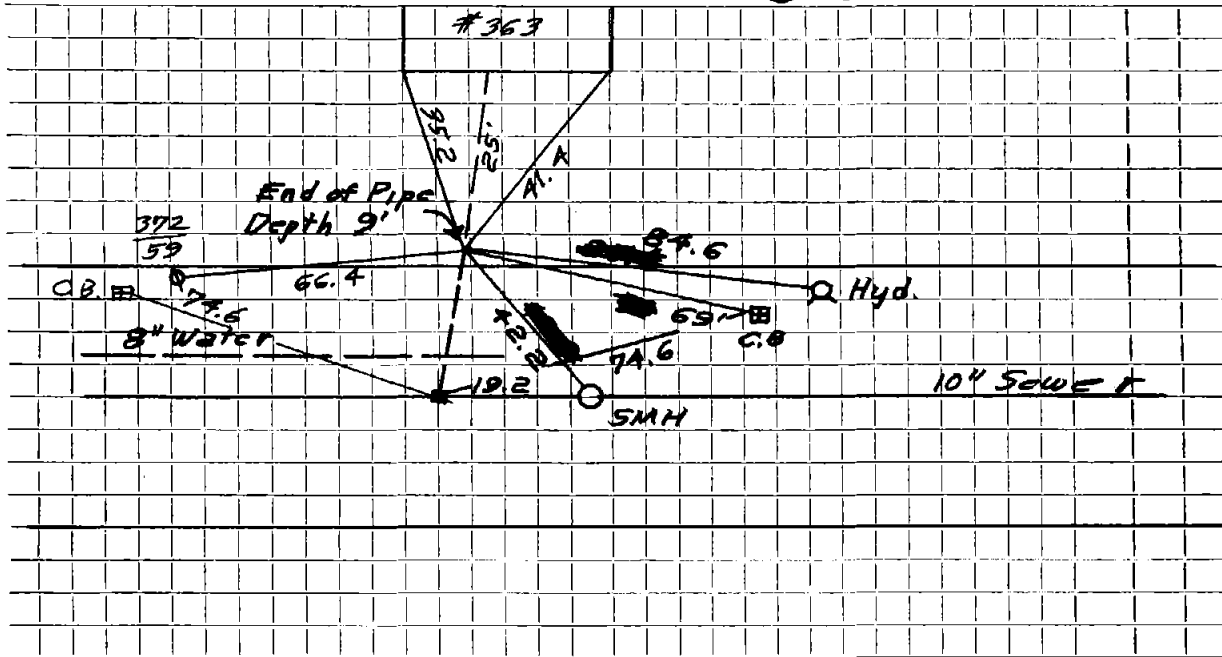

Connection made in ..... Street. Work completed .....

Remarks: .....

.....

.....