

Name Benjamin Franklin Homes.

Service No. 34

Address 365 Emerson Road

Location

Kind of Pipe

Size

Size of Main

~~REPAIR/REWORK~~ — New Service


Richard Stevens Permit #273

Location AUG 9 1965

Date	Material	Amount	Total	Date	Amount
9-25-62	Labor	14.83		4-20-65	Deposit
9-26-62	"	73.49	88.32		140.01
	10% O.H.	8.83	97.15		
	40' 6" Transite pipe @.82		32.80	9-25-62	
	1 6" 90° Transite elbow		4.09	40' 6" Transite	
	2 hrs. Trucking @3.00		6.00	1 6"-90° Elbow	
	BILL WHEN CONNECTED		140.04		
7-19-65	44' 6" Transite pipe				

DATE _____

TOWN OF LEXINGTON — BOARD OF PUBLIC WORKS
SEWER DIVISION

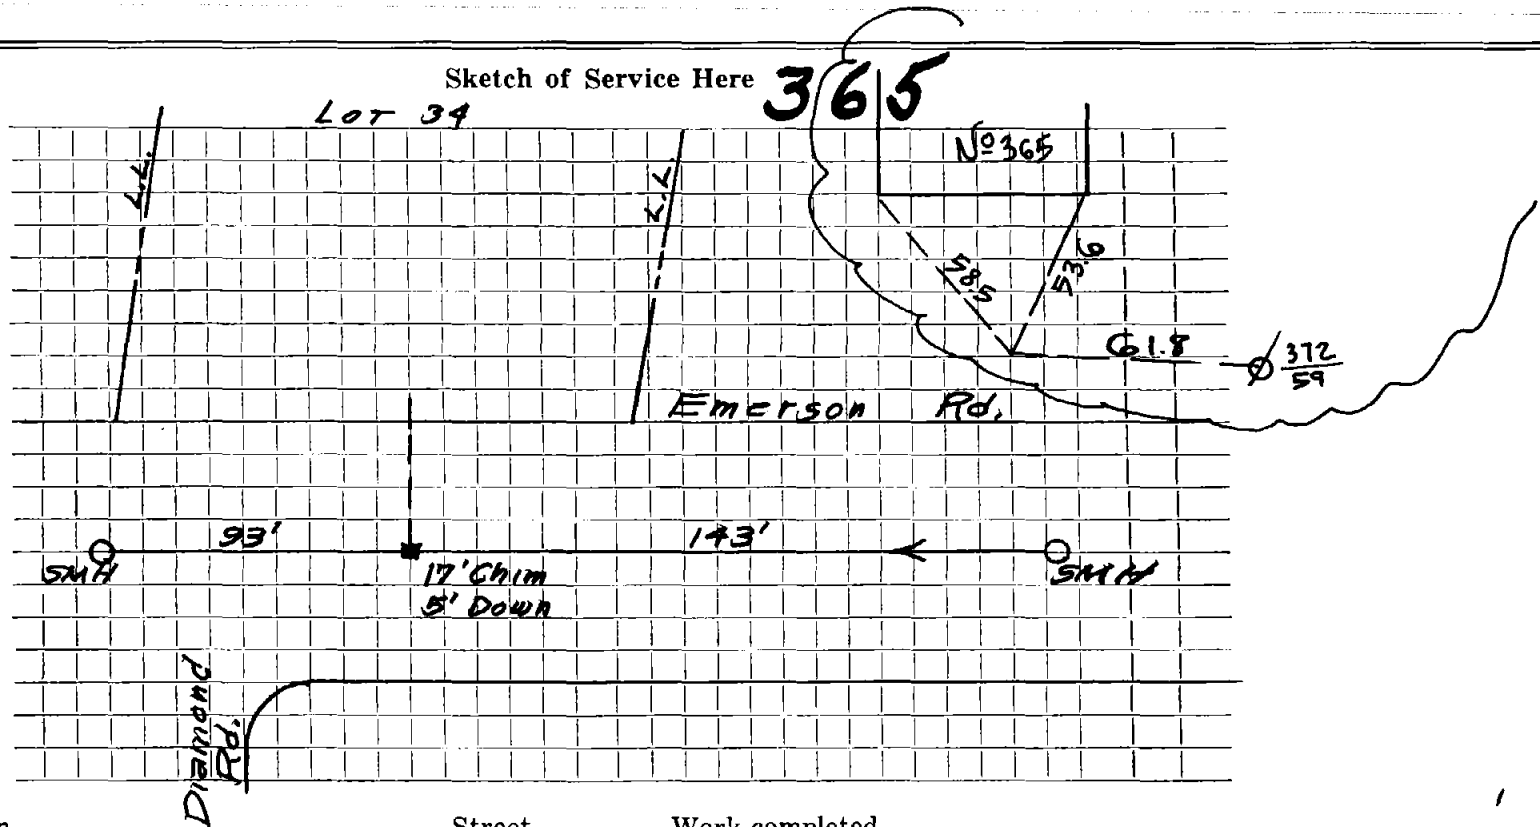

Connection made in Street. Work completed

Remarks:
.....
.....