


DATE _____

TOWN OF LEXINGTON — BOARD OF PUBLIC WORKS

SEWER DIVISION

Sketch of Service Here

LOT 27
8.3 Acres

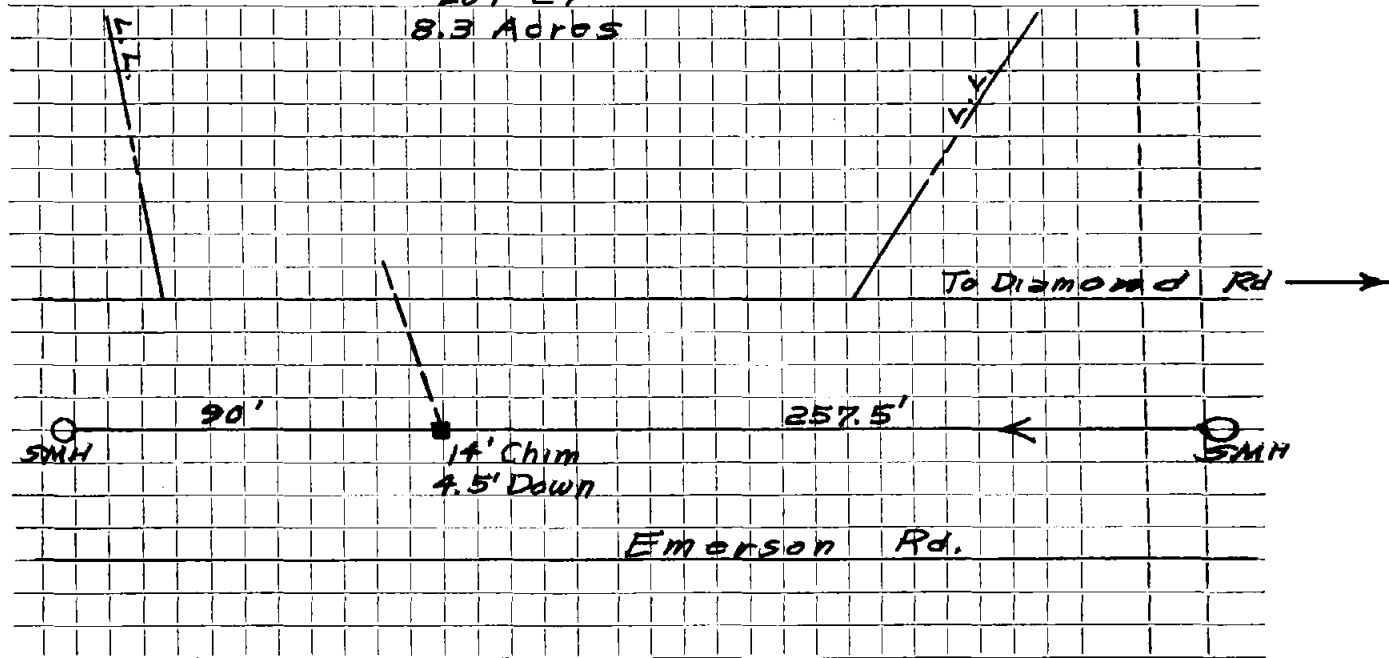


Connection made in Street. Work completed

Remarks:

.....

.....

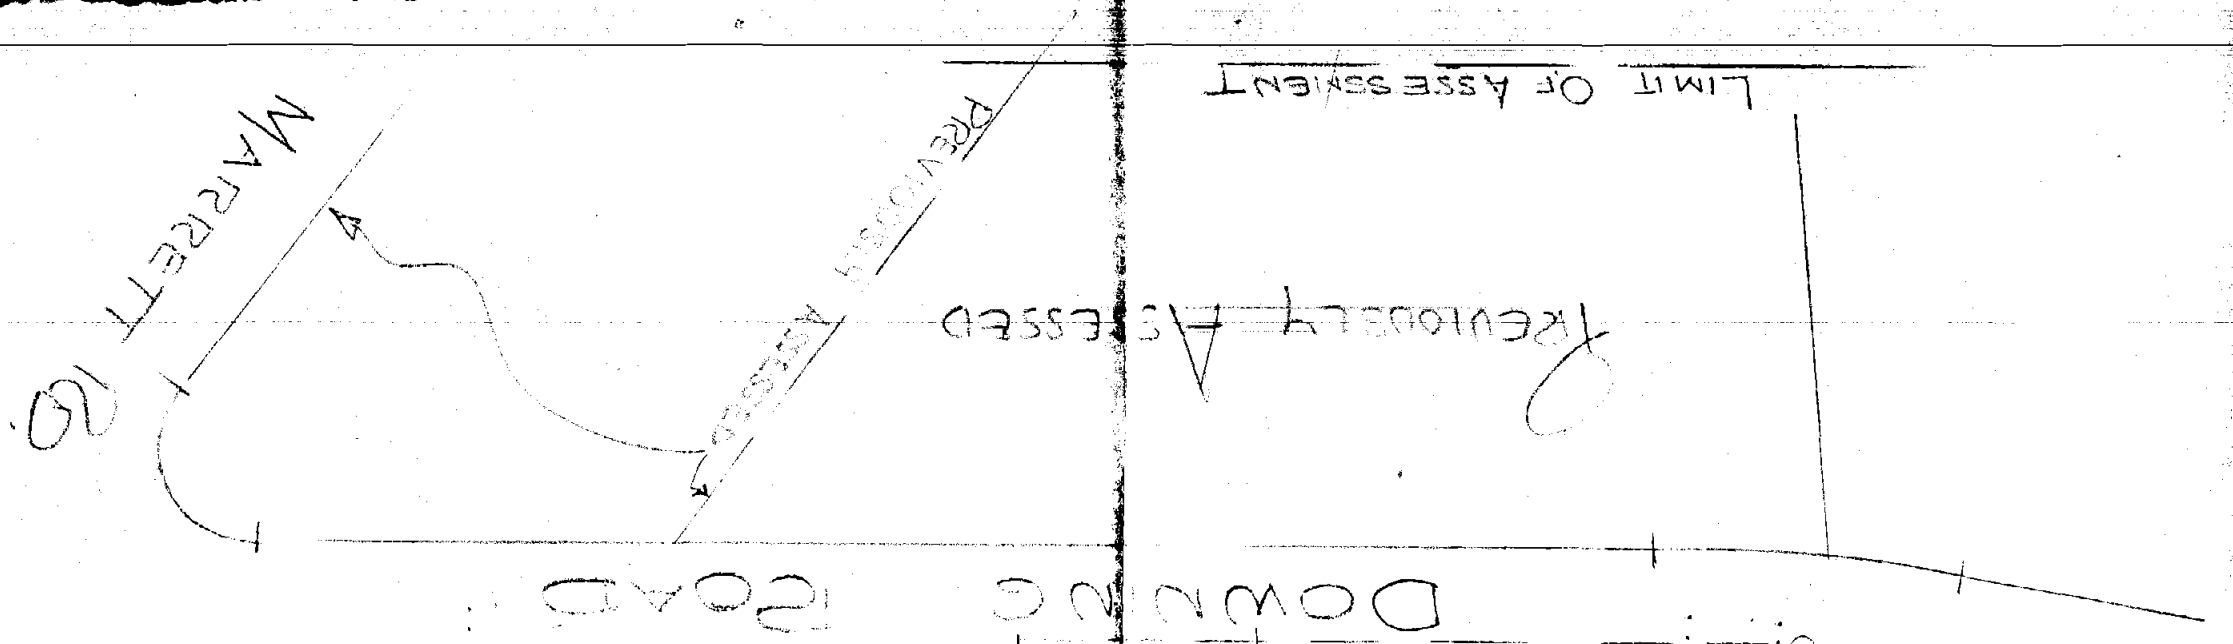

#

500 D°

230 25

BARBARA

WILLIAM

145-2-

Lot 2

100'

LIMIT OF ASSESSMENT

