

Name John H ~~O~~ldsworth

Service No. 62

Address ~~10 Lee Street~~ 0 Essex Street
per Eng. Dept. 5/2/86

Location

Kind of Pipe

Size

Size of Main

~~Revised Estimate~~ — New Service Suburbanite Cesspool - Permit #301 - W.O.#342

Location

MAR 14 1966

Date	Material	Amount	Total	Date	Amount
10/65	Labor	59 50		5-24-65	100 00
	10% O.H.	5 95	65 45	3-30-66	26 37
20'	6" Transite pipe @ .82		16 40		126 37
12	Bricks @ 4.20 per 100		52	6-10-65	
$\frac{1}{2}$	Bag Cement @ 1.50		75	20' 6" Transite	
7000	Lbs. Stone @ 1.50 per ton		5 25		
	19 x 3 Patch		19 00		
2	Hrs. Town Truck @ 3.00		6 00		
2	Hrs. Town Shovel @ 6.50		13 00		
			126 37		
1/65	27' 6" Transite pipe				


B.L. ...

DATE _____

TOWN OF LEXINGTON — BOARD OF PUBLIC WORKS

SEWER DIVISION

Sketch of Service Here

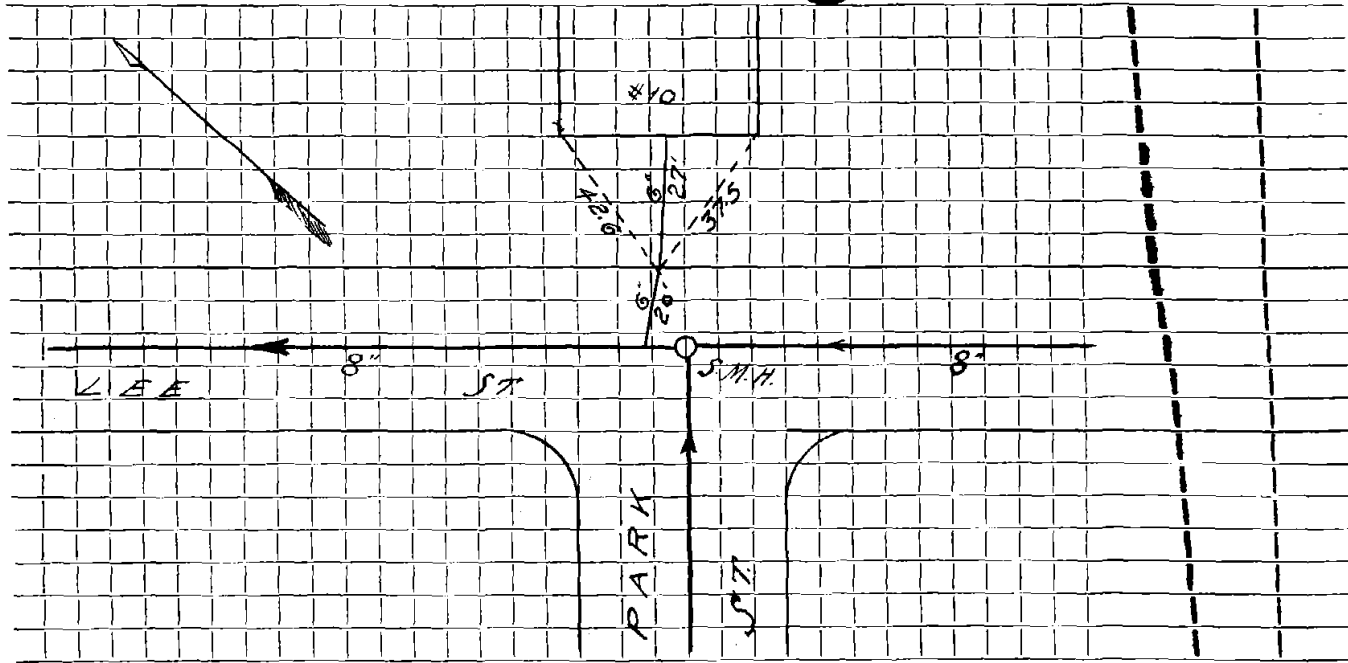

Connection made in Street. Work completed

Remarks:

.....
.....