

Name Armand Pellegrini

Service No. 18

Address # 10 ESSEX ST.

Location

Kind of Pipe

Size

Size of Main

~~Repair~~ ~~Recess~~ ~~Work~~ New Service DeFelice #973 W.O. #6465

Location AUG 5 1968


Date	Material	Amount	Total	Date	Amount	
4/11/68	Labor	86 46		4-9-68	Deposit	430 00
5/8/68	Labor	10 04		8-5-68	Retard	219 23
5/8/68	Labor	15 06				300 57
	10% O. H.	11 16	122 72	4-11-68		
	20' 6" Sewer pipe @ .88		17 60		20' 6" Sewer Pipe	
	1 11 1/4 elbow		2 35		1 6"-11 1/4" Elbow	
	2 ton hot top @ 5.80		11 60			
	5 hrs. trucking @ 3.00		15 00			
	3 hrs. shovel @ 6.50		19 50			
	1 hr. sweeper		3 00			
	1 hr. compressor		5 00			
	1/2 hr. roller @ 3.00		1 50			
	trailer		2 00			
	TOTAL COST		200 27			
-8-68	27' 6" Transite pipe					
	5' 4" Cast Iron Pipe					

DATE _____

TOWN OF LEXINGTON — BOARD OF PUBLIC WORKS

SEWER DIVISION

Sketch of Service Here / 0

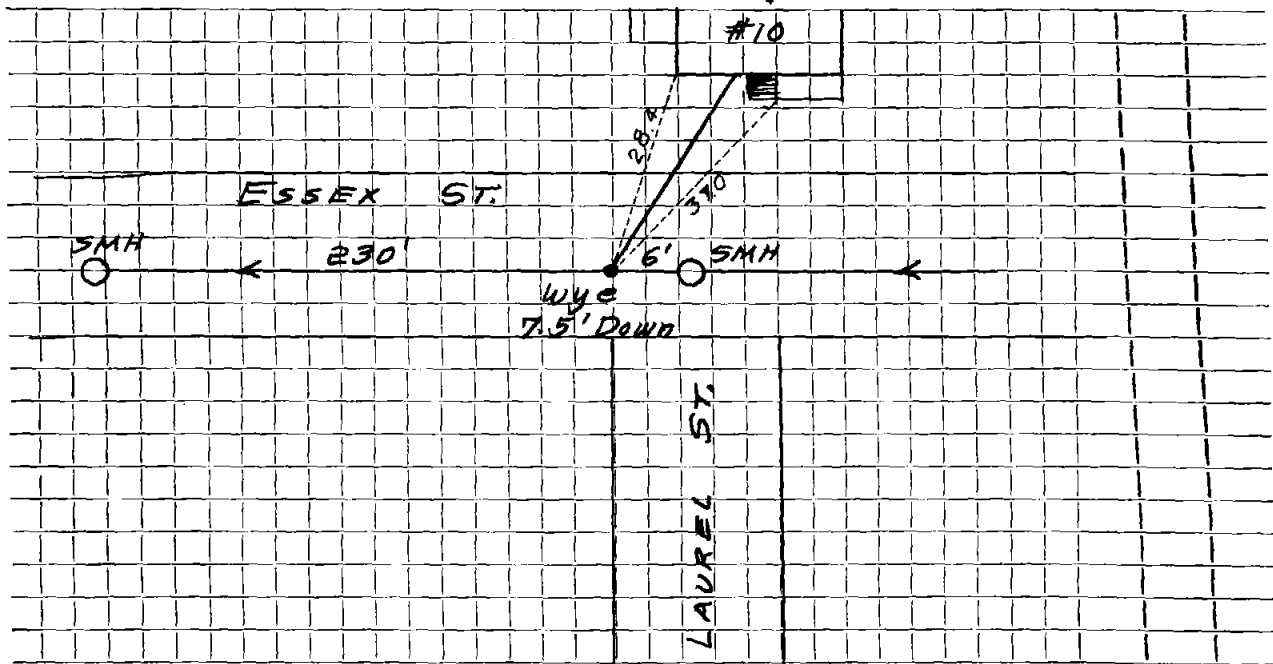

Connection made in Street. Work completed

Remarks:
.....
.....