

Name Robert G. Boleyn

Service No. 92

Address # 2 ESSEX ST.

Location

Kind of Pipe

Size

Size of Main

~~Repair - Renewal~~ New Service

WO # 2393

Location Comm 10-1-62


Date	Material	Amount	Total	Date	Amount	
7-10-62	Labor	79.03		6-22-62	Deposit	200.00
7-11-62	"	49.74	128.77	10-16-62		28.65
	10% O. H.	12.88	141.65			228.05
	40' 6" Transite pipe @.78		31.20			
	1 11 1/2" Transite Elbow		2.35			
	1 22 1/8" Transite Elbow		2.35			
	4 hrs. Town Truck @3.00		12.00			
	3 hrs. Town Shovel @6.50		19.50			
	1 hr. Loader @3.00		3.00			
	16 x 3 Patch		16.00			
			228.05			

DATE _____

TOWN OF LEXINGTON — BOARD OF PUBLIC WORKS

SEWER DIVISION

Sketch of Service Here

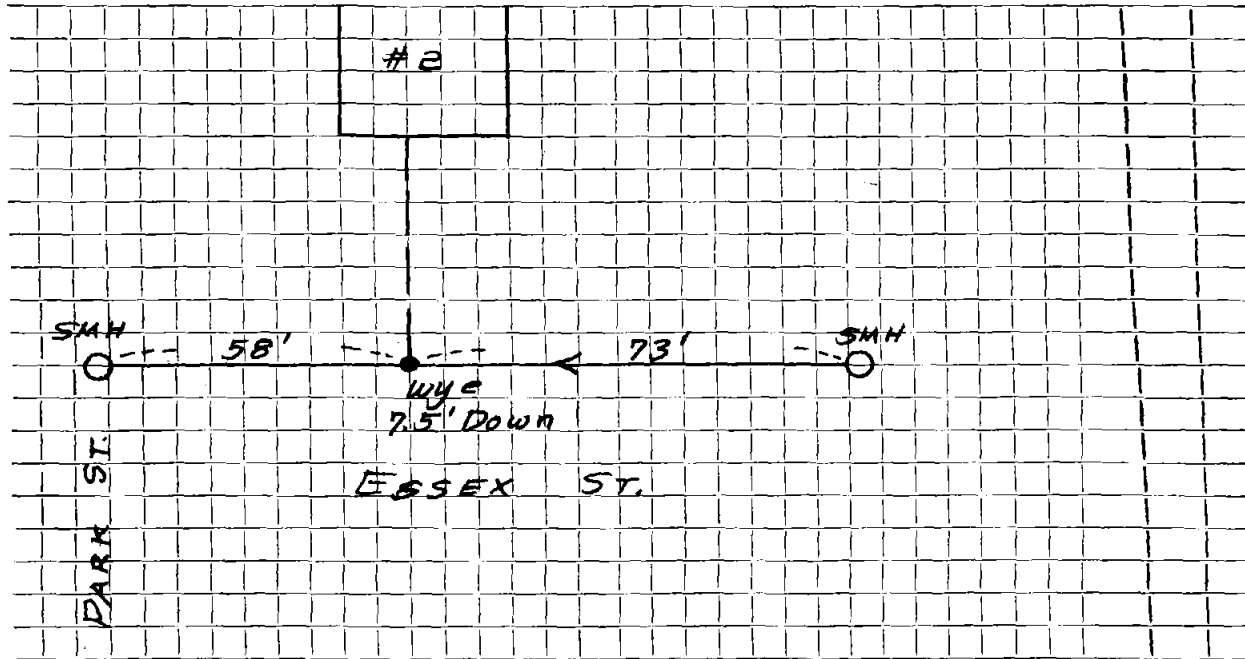

Connection made in Street. Work completed

Remarks:

.....
.....