

Name **Domenic Simeone**

Service No. 112

Address **# 3 ESSEX ST.**

Location

Kind of Pipe

Size

Size of Main

~~Repair/Replace~~ **New Service**

WO # 7489

Location

Comm 10-29-62

Date	Material	Amount	Total	Date	Amount
8-24-62	Labor	51.10		7-24-62	250.00
	10% O.H.	5.11	56.21	10-29-62	123.04
	38' 6" Transite pipe @82		31.16		126.96
	1 90° Transite Elbow		4.09		
	3 Hrs. Town Shovel @6.50		19.50		
	2 Hrs. Trucking @3.00		6.00		
	10X3 Patch		10.00		
			126.96		


DATE _____

TOWN OF LEXINGTON — BOARD OF PUBLIC WORKS

SEWER DIVISION

Sketch of Service Here

3

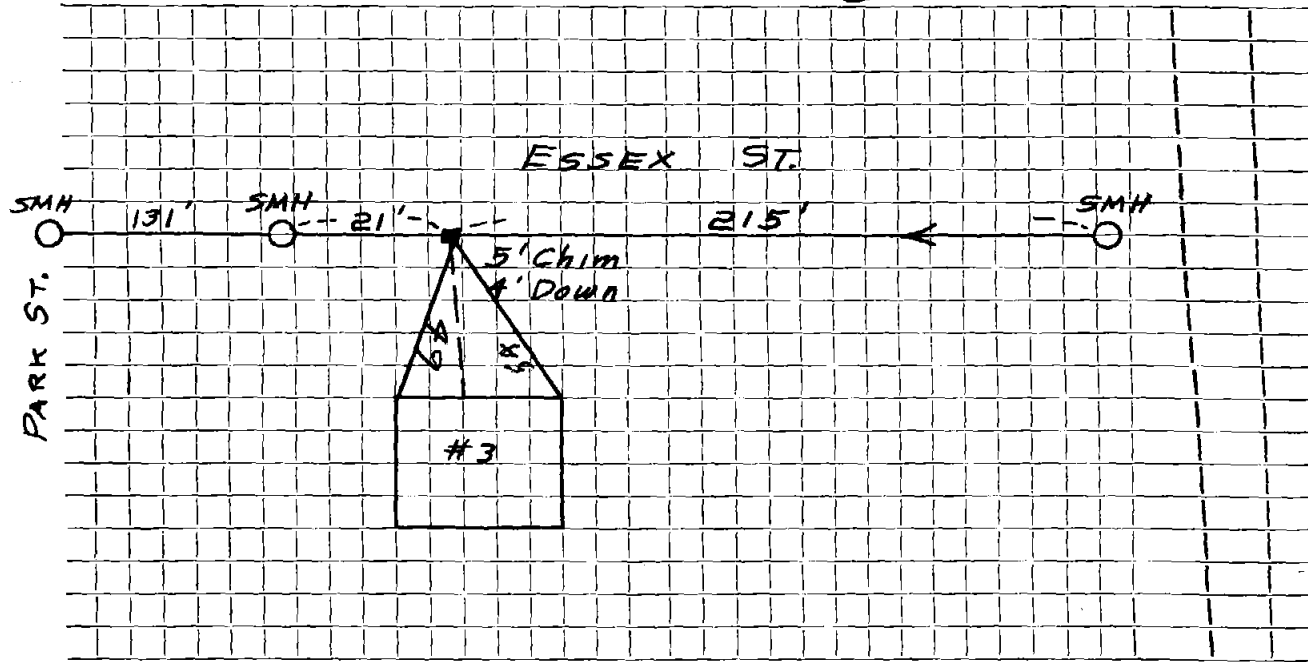

Connection made in Street. Work completed

Remarks:

.....

.....