

Name Edward Simeone

Service No. #106

Address # 5 ESSEX ST.

Location

Kind of Pipe

Size

Size of Main

~~Repair~~ ~~Renewal~~ — New Service

WO # 7466

Location Camm 10-29-62


Date	Material	Amount	Total	Date	Amount
7-24-62	Labor	63.38		7-13-62	250.00
	10% O.H.	6.34	69.72	10-29-62	118.23
	37' 6" Transite pipe @82		30.34		131.27
	1 6" Duplex Adapter		1.62		
	1 900 Transite Elbow		4.09		
	3 Hrs. Town Shovel @6.50		19.50		
	2 Hrs. Trucking @3.00		6.00		
			131.27		

DATE \_\_\_\_\_

TOWN OF LEXINGTON — BOARD OF PUBLIC WORKS

SEWER DIVISION

Sketch of Service Here

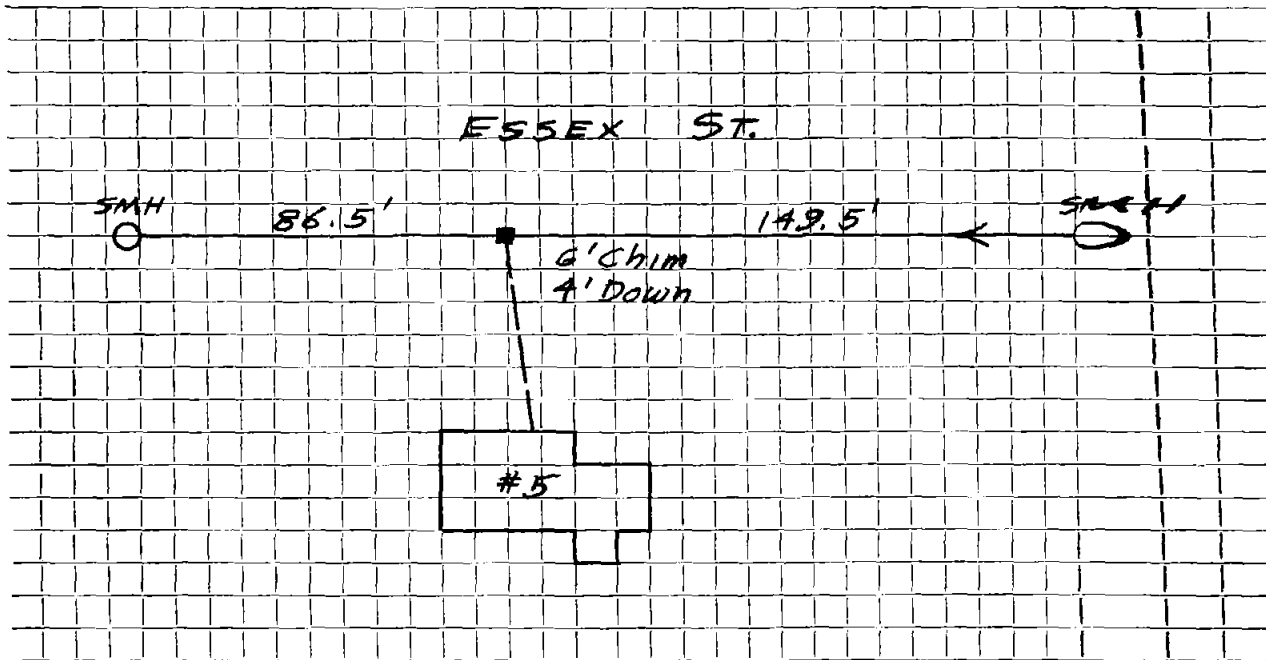

Connection made in ..... Street. Work completed .....

Remarks: .....  
.....  
.....