

Name A. C. Metro

Service No. 191

Address # 6 ESSEX ST.

Location

Kind of Pipe

Size

Size of Main

~~Repair/Replacement~~ — New Service W.C.F. 77-25

Location Comm 1-14-63

Date	Material	Amount	Total	Date	Amount
11-20-62	Labor	74.16		11-13-62	200.00
11-21-62	"	91.53	165.69	8-16-67	112.98
	10% O.H.	16.57	182.26		312.98
	32' 6" Transite pipe @.82		26.24		
	6 Sticks Dynamite @.27		1.62		
	7 Blasting Caps @.28		1.96		
	6 3/4ton Fill @.70		4.72		
	2 11 1/4° Transite Bends @4.09		8.18		
	12 x 3 Patch		12.00		
	6 hrs. Towm Shovel @6.50		39.00		
	4 hrs. Trucking @3.00		12.00		
	1 hr. Compressor @5.00		5.00		
	Spring Loam & Seed		20.00		
			312.98		


DATE _____

TOWN OF LEXINGTON — BOARD OF PUBLIC WORKS

SEWER DIVISION

Sketch of Service Here

6

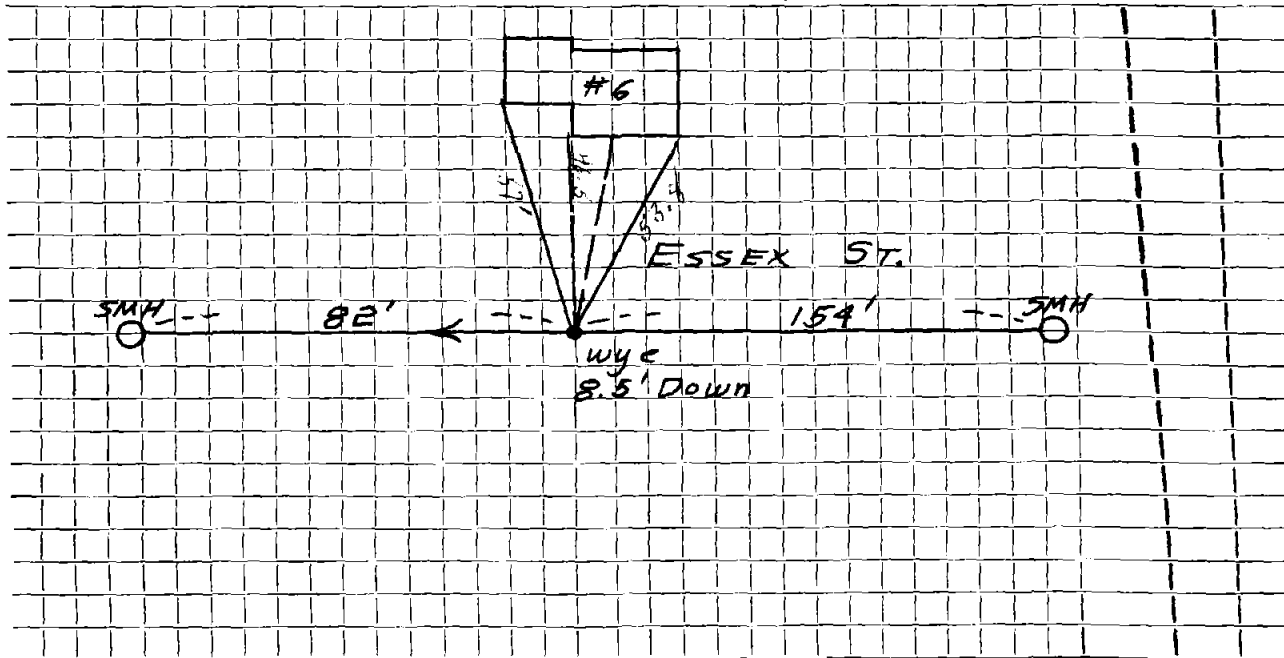

Connection made in Street. Work completed

Remarks:

.....
.....