


DATE 3/18/2020

TOWN OF LEXINGTON — BOARD OF PUBLIC WORKS
SEWER DIVISION

Sketch of Service Here

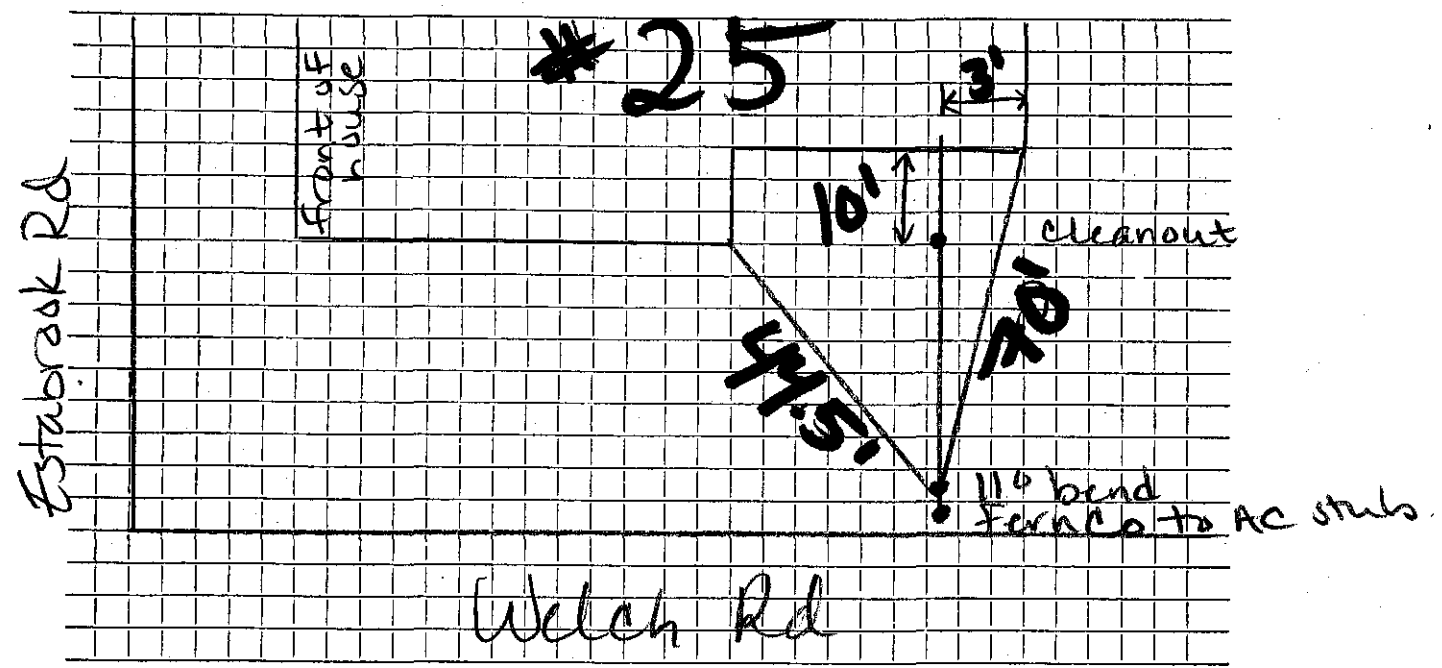

Connection made in Welch Rd Street. Work completed

Remarks: Address : 25 Estabroak Rd