

Name

Service No.

Address

10 ~~15~~ Stabrook Rd.

Location

Kind of Pipe

Size

Size of Main

Repair—Renewal

—New Service

Location

Date

Material

Amount

Total

Date

Amount

12-7-65

SLUDGE

6-24-66

Solids - Richards

10-2-66

HEAVY MATERIAL

3-24-67

PAPERS

9-3-68

Solids

5-19-75

Solids

2-21-75

SOLIDS


1/22/77

Solids

DATE _____

TOWN OF LEXINGTON — BOARD OF PUBLIC WORKS
SEWER DIVISION

Sketch of Service Here

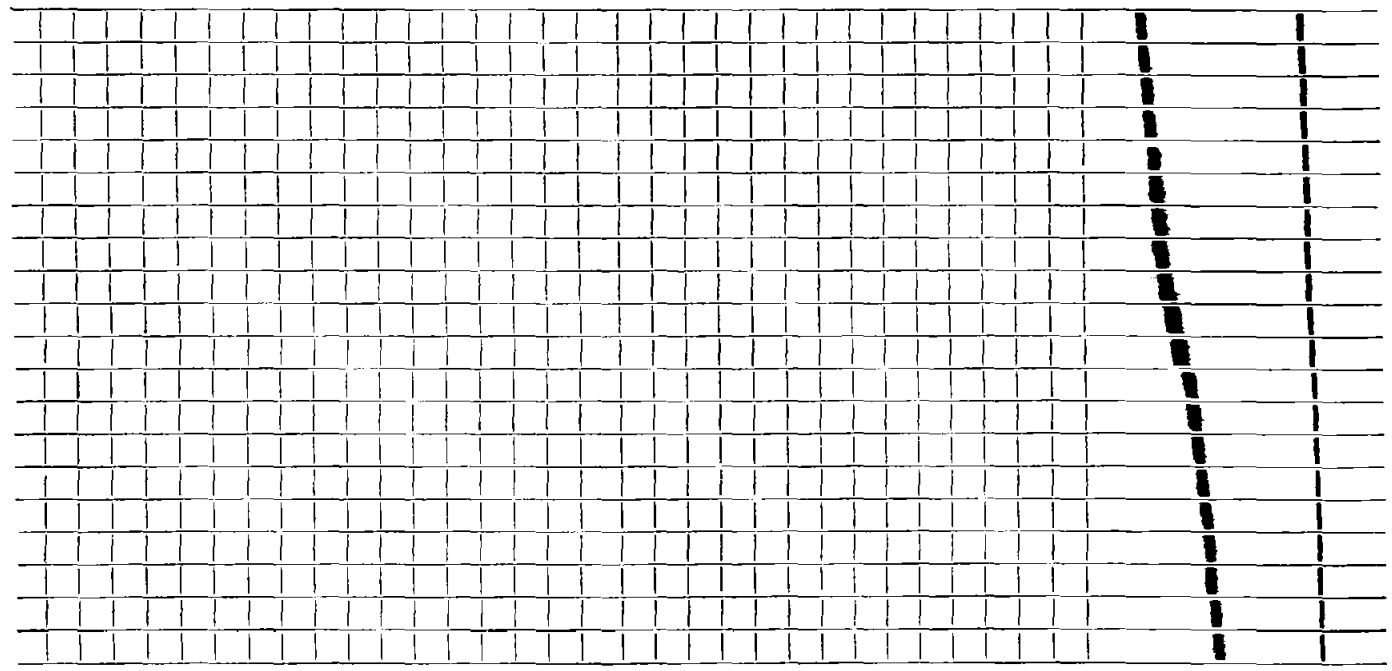

Connection made in Street. Work completed

Remarks:
.....
.....