

Name

Service No.

Address

20 Esterbrook

Location

Kind of Pipe

Size

Size of Main

Repair—Renewal—New Service

Location

Date

Material

Amount

Total

Date

Amount

11-29-04

8"X8X6 TEE

10'-4" PVC

58' - 6" PVC


4X6 PVC to PVC FERNCO

DATE _____

TOWN OF LEXINGTON — BOARD OF PUBLIC WORKS

SEWER DIVISION

Sketch of Service Here

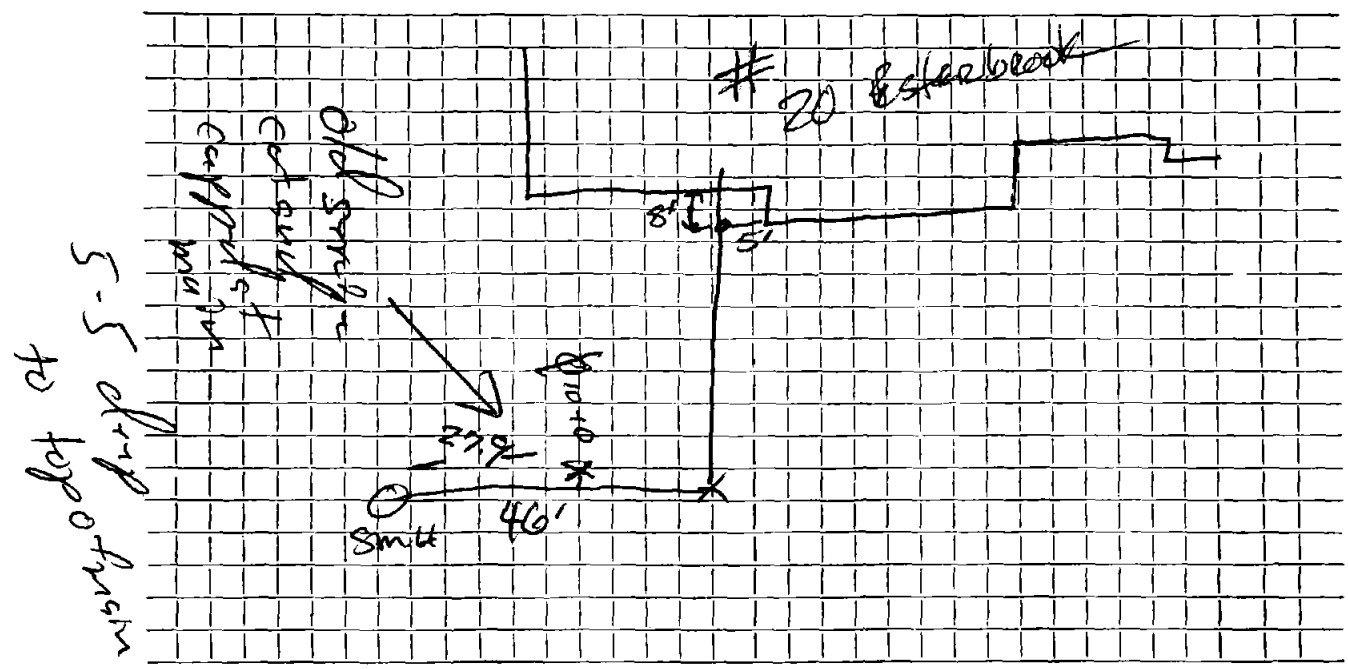

Connection made in Street. Work completed

Remarks: SERVICE INSTALLED TO MAIN