

Name Edward V. Shenrock

Service No. 33

Address 27 Estabrook Road

Location

Kind of Pipe

Size

Size of Main

~~Repair~~ ~~Reb~~ ~~XX~~ ~~XX~~ ~~XX~~ New Service *W off 860 p*

Location JUN 29 1964


Date	Material	Amount	Total	Date	Amount
5-19-64	Labor	36 00		3-25-64	100 00
	10% O. H.	3 60	39 60	6-29-64	24 01
	12 6" Transite Pipe @.82		9 84		75 99
	1 90° Transite Elbow		4 09		
	1 8X6 Saddle		5 25		
	1 12" Nipple		1 21		
	1 Hr. Trucking @3.00		3 00		
	2 Hrs. Town Shovel @6.50		13 00		
			75 99		

DATE \_\_\_\_\_

TOWN OF LEXINGTON — BOARD OF PUBLIC WORKS

SEWER DIVISION

Sketch of Service Here

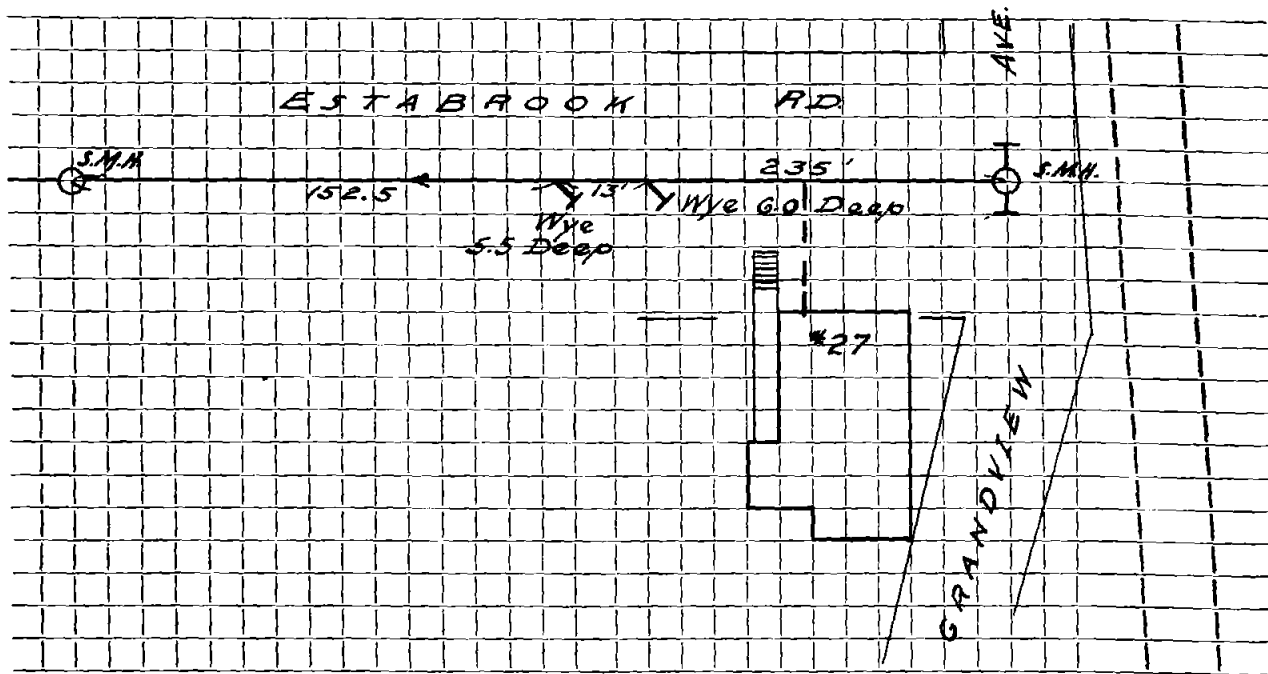

Connection made in ..... Street. Work completed .....

Remarks: *Style 360 clamp on sewer service in water main trench 5-15-80* *JH*  
*water main 6" under sewer service*