

Name **Richard** W. Young

Service No. 32

Address 28 Estabrook Road

Location

Kind of Pipe

Size

Size of Main

~~Repair-Renewal~~ **New Service**

Wo # 8620

Location JUN 29 1964


Date	Material	Amount	Total	Date	Amount
5-19-64	Labor	36 00		3-25-64	175 00
	10% O.H.	3 60	39 60	5-29-64	95 32
	10' 6" Transite Pipe @.82		8 20		79 68
	1 22 $\frac{1}{8}$ " Transite Elbow		2 35		
	1 11 $\frac{1}{4}$ " Transite Elbow		2 35		
	2 Hrs. Trucking @3.00		6 00		
	2 Hrs. Town Shovel @6.50		13 00		
			79 68		

DATE _____

TOWN OF LEXINGTON — BOARD OF PUBLIC WORKS

SEWER DIVISION

Sketch of Service Here

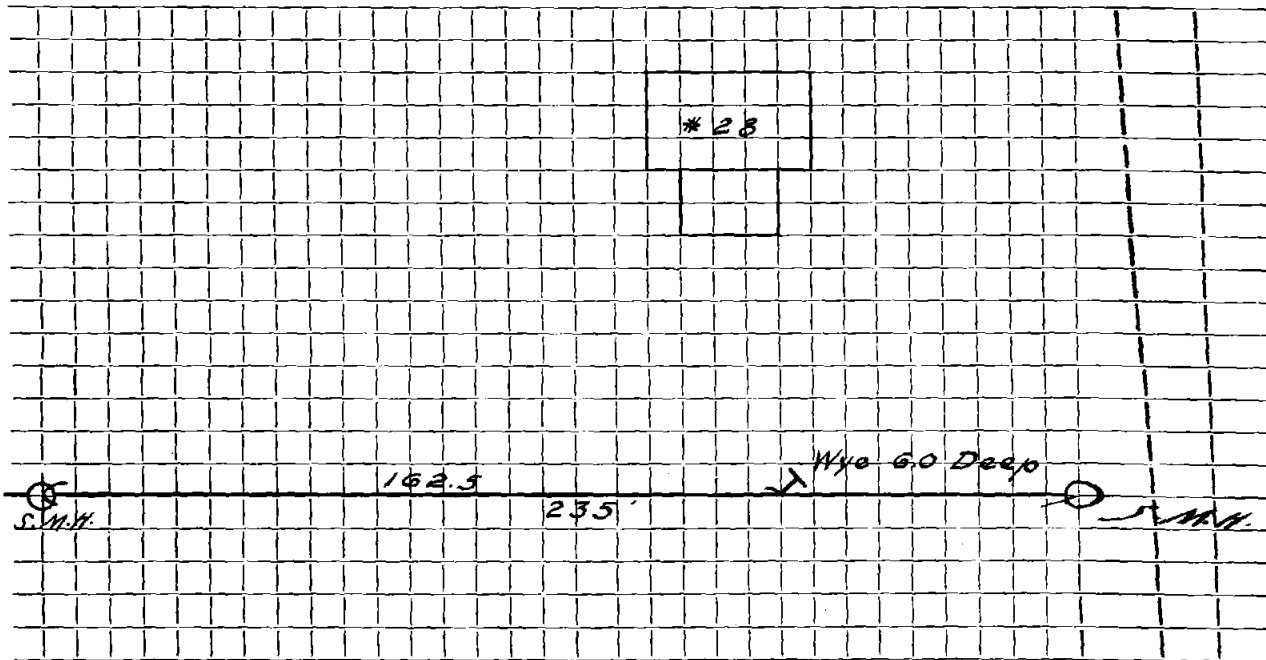

Connection made in Street. Work completed

Remarks:

.....
.....