


DATE _____

TOWN OF LEXINGTON — BOARD OF PUBLIC WORKS

SEWER DIVISION

Sketch of Service Here

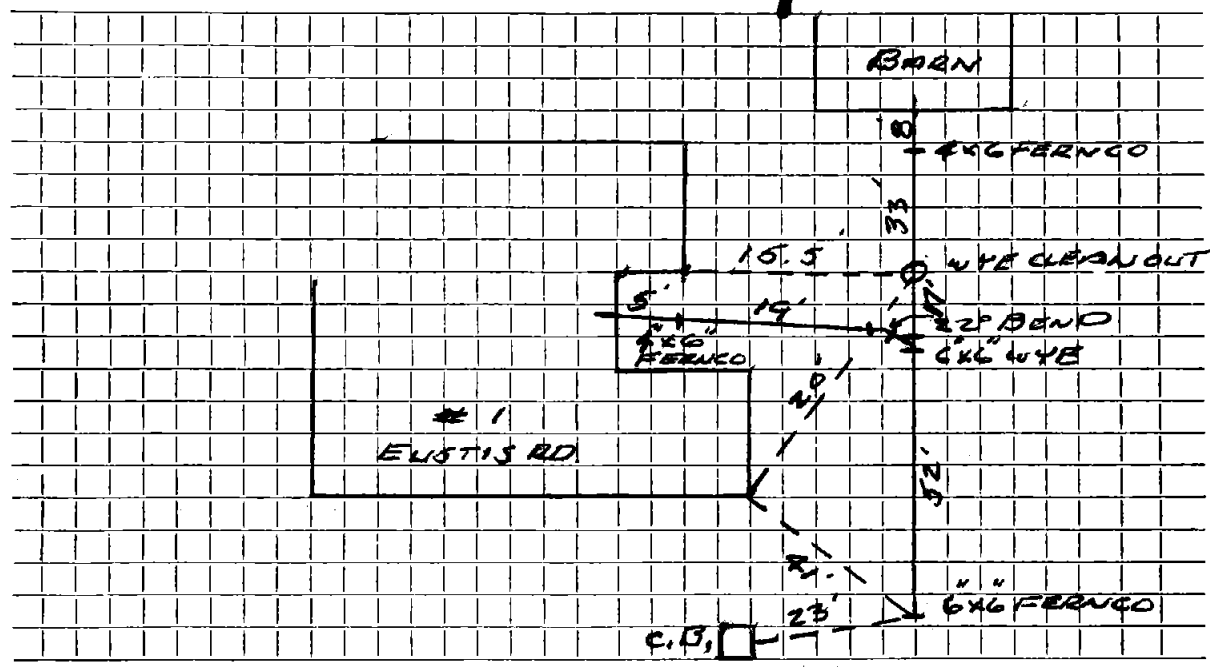

Connection made in EUSTIS RD. Street. Work completed

Remarks: Original Service 5-3-51