

Name **John D. Trenholm**
 Address **2 Eustis St., Lexington**

Service No. ~~50~~ ³¹ 231

Location

Kind of Pipe

Size

Size of Main

~~Repair-Renewal~~—New Service

Location

Date	Material	Amount	Total	Date	Amount
11/8/35	120 hrs. labor @ 55¢	\$ 66 00		<i>Oct 30. 1935 Deposited</i>	100 00
<i>Com. #100.00 12-30-35 L Russell</i>	36 " " @ 60¢	<u>21 60</u>			
	Total labor		87 60		
60'	6" Sewer Pipe @ 16¢	9 60			
	Trucking 2 hrs. @ 75¢	1 50			
	Comp. 1 hrs. @ \$2.50	<u>2 50</u>			
			<u>13 60</u>		
			\$101 20		
	Say: \$100.00				
	Labor				

Hadley Press, Inc., Lexington

TOWN OF LEXINGTON—BOARD OF PUBLIC WORKS

SEWER DIVISION

DATE October 26, 1935

NO. _____


The undersigned applies for the construction of a particular sewer connecting No. 2 Eustis St. Street and hereby agrees to comply with the Rules and Regulations governing the construction and use of Particular Sewers, as now or at any future time established by the Board of Selectmen.

Am't. of Estimate \$ _____

Am't. Paid \$ _____

John D. Breckley Owner

Sketch of Service Here

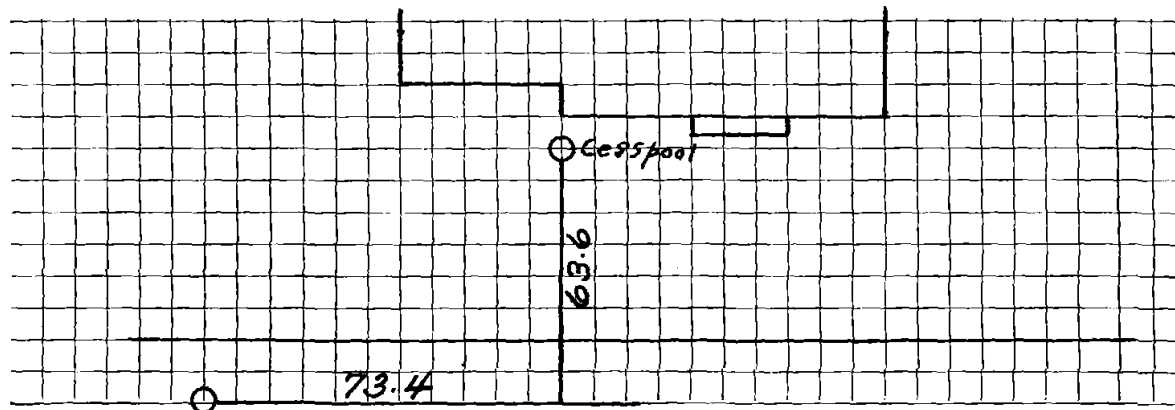

Connection made in _____ Street.

Work completed _____ 19

Remarks: