

Name

Service No.

Address 3 Evergreen

Location

Kind of Pipe

Size

Size of Main

Repair—Renewal—New Service

Location


Date	Material	Amount	Total	Date	Amount
					Outside
7-28-99	Inside			12-20-93	16'-6" PVC 1-4x6 CI-PVC Fernco 1-6" AC-PVC Fernco
	1-4x6 CI to PVC Fernco				
	1-6x6x4 wye cleanout				
	1-6x6 PVC to PVC Fernco				
	20'-6" PVC pipe				
				12-3-93	Repts. 32' dia. Respond if called

DATE 12.21.93

TOWN OF LEXINGTON — BOARD OF PUBLIC WORKS

SEWER DIVISION

Sketch of Service Here **3**

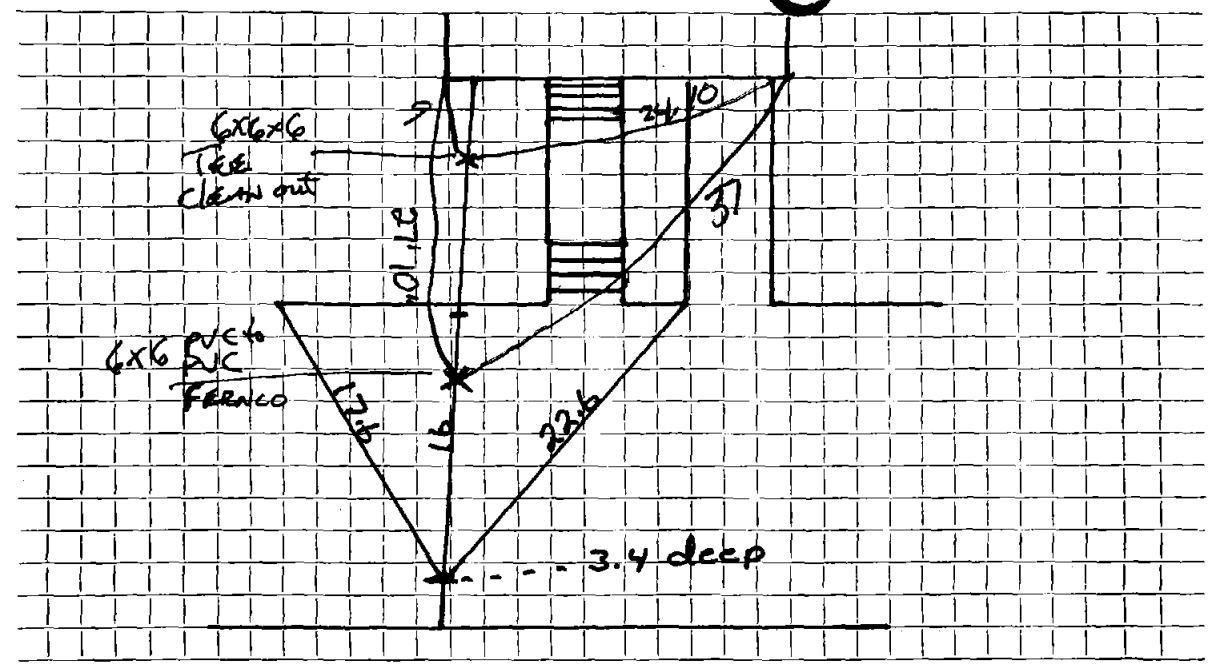

Connection made in Street. Work completed 12.20.93

Remarks: 1' deep at wall

INSIDE RENEWED 7.28.99