


DATE SEPT. 24 1997

TOWN OF LEXINGTON — BOARD OF PUBLIC WORKS
SEWER DIVISION

Sketch of Service Here

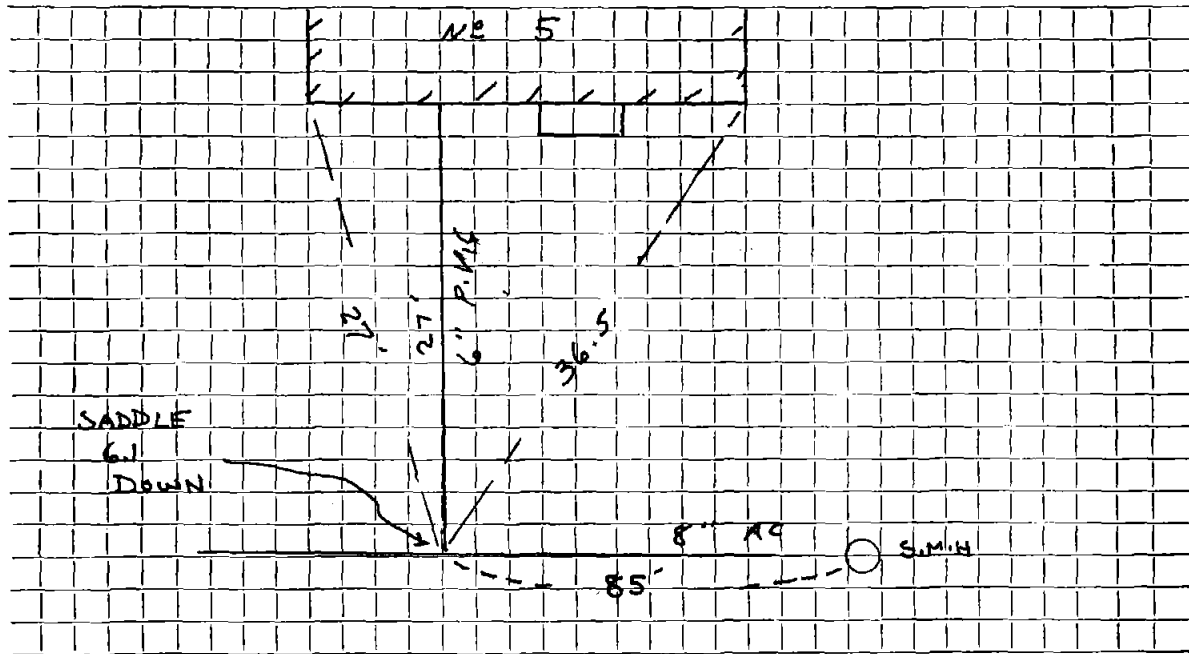

Connection made in EVERGREEN Street.

Work completed PAUL ROCKWELL CONST.

Remarks:

FIELD BOOK 97-4

TJM