


DATE 5/2/2019

TOWN OF LEXINGTON — BOARD OF PUBLIC WORKS
SEWER DIVISION

Sketch of Service Here

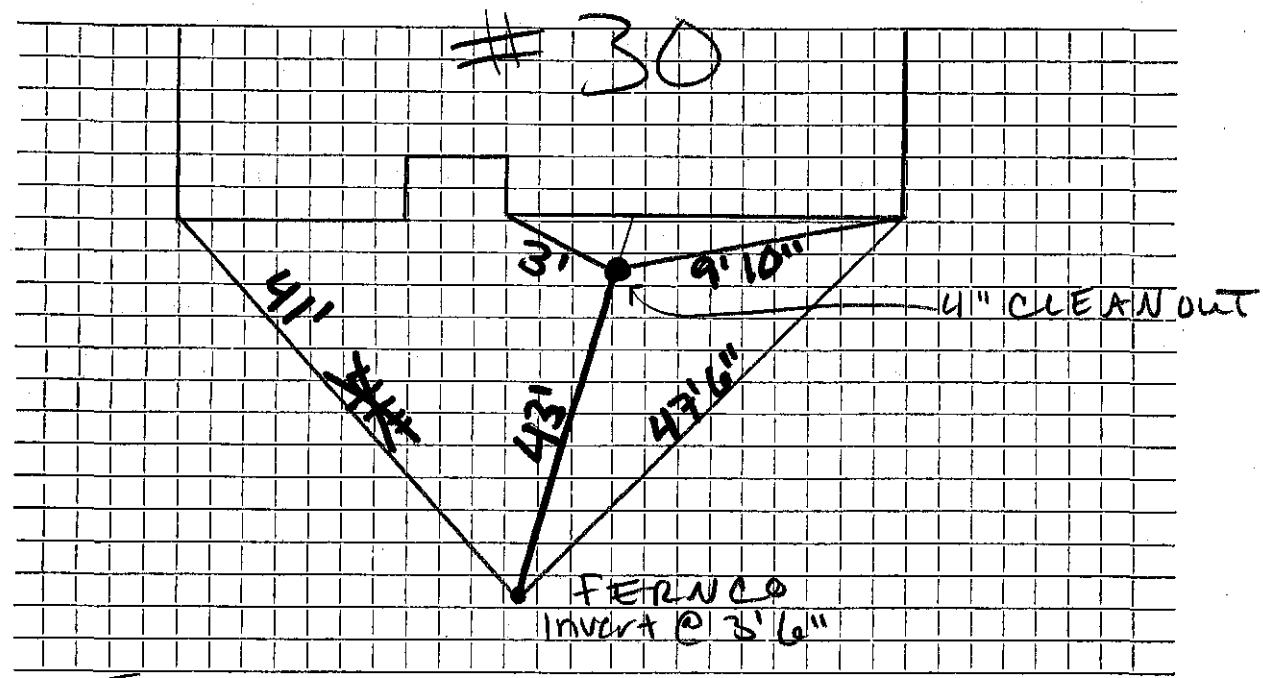

Connection made in Ewell Ave Street. Work completed

Remarks: Tier taken from McLaughlin's box