

Name Edward J. Murray

Service No.

Address #1 EWELL

Location

Kind of Pipe PVC

Size 6"

Size of Main

Repair—Renewal—New Service Arlex #0202

Location


Date		Material	Amount	Total	Date	Amount
8/28	92	10 LF 4" CI				
		32 LF 6" PVC				
		4" X 6" FERNCO			6-18-80	
		6" X 6" FERNCO			2	6" X 5' Transite Nipples
					1	6" Fernco Couplings
					1	6" Transite To Clay Adapter
					5-27-92	ROOTS
					6-10-88	ROOTS
					7-22-83	40'-50' from Manhole Flat Spot

DATE 8/28/92

TOWN OF LEXINGTON — BOARD OF PUBLIC WORKS

SEWER DIVISION

Sketch of Service Here

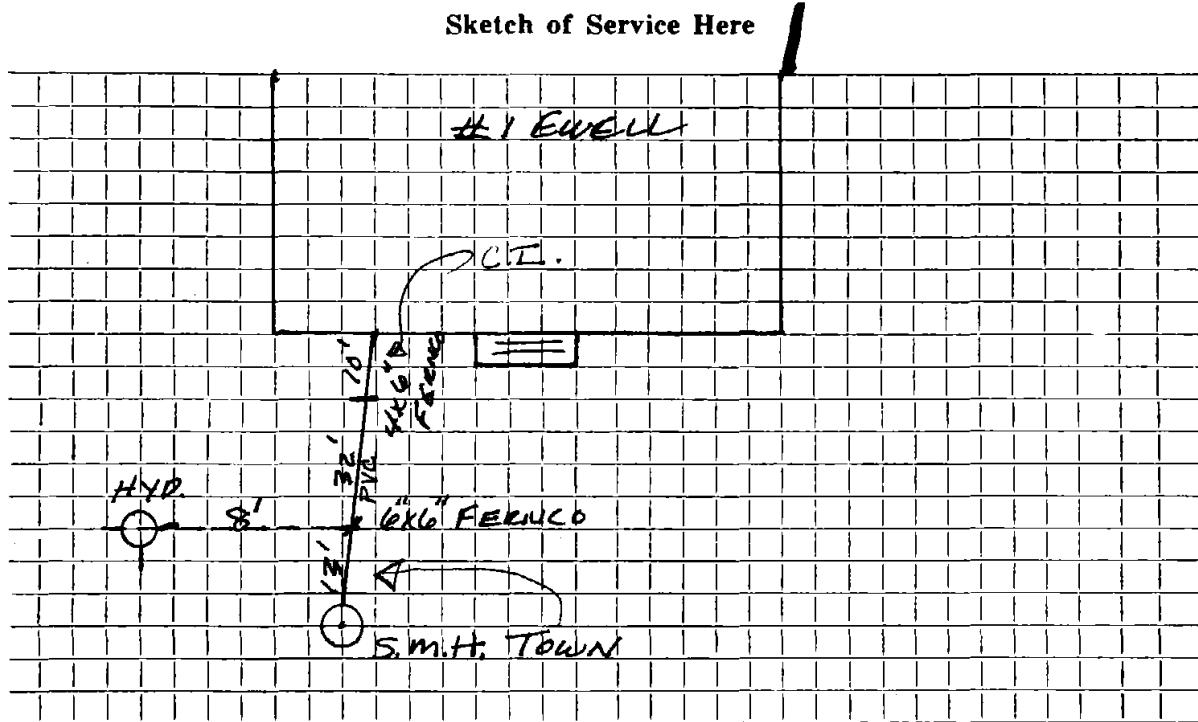

Connection made in #1 EWELL Street. Work completed BY ARLEX

Remarks: INSPECTED: C.R.G. Original Service 7-21-54