

Name **Robert Kitfield**

Service No.

Address **12 Ewell Ave.**

Location

Kind of Pipe

Size

Size of Main

~~Repair & Renewal~~ — New Service

Renewal Valeri #4086

Location

Date

Material

Amount

Total

Date

Amount

1953 - installed 53'

11/2/82 40' x 6" PVC Pipe

1 4" x 6" Donut

OUTSIDE

11/2/82 13' x 6" PVC pipe

Labor

5-16-79 Routs every 2 ft

TOWN OF LEXINGTON—DEPT. OF PUBLIC WORKS  
SEWER DIVISION

DATE .....


NO. ....

The undersigned applies for the construction of a particular sewer connecting No. ....  
Street and hereby agrees to comply with the Rules and Regulations governing the construction **and** use of Particular  
Sewers, as now or at any future time established by the Board of Selectmen.

Am't of estimate \$.....

Am't Paid \$.....

..... Owner

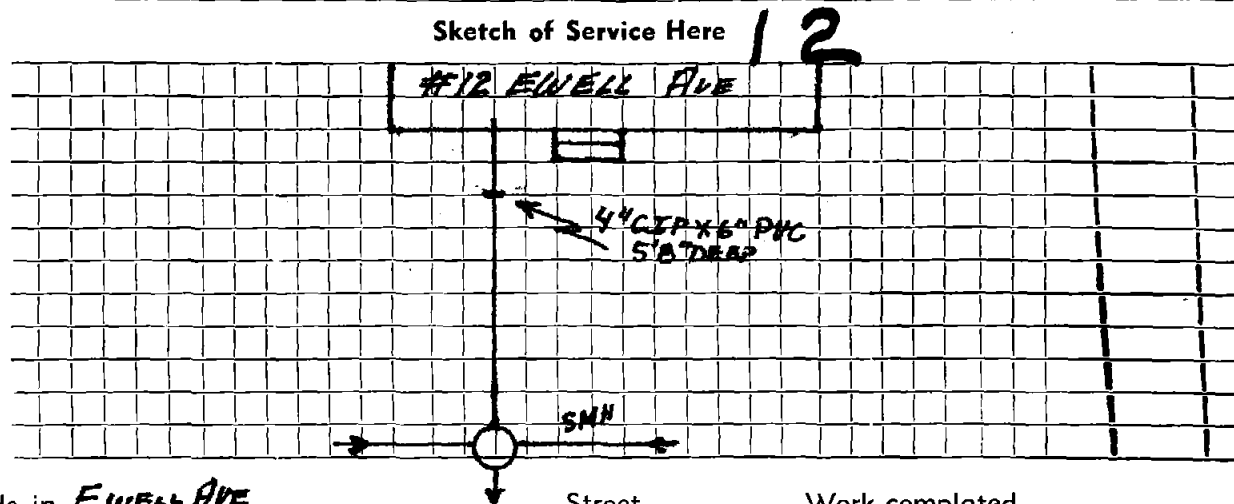

Connection made in EWELL AVE ..... Street.

Work completed .. - - - - - 19..

Remarks: