

Name Donna Realty Trust

Service No. 33

Address 17 Ewell Avenue

Location

Kind of Pipe

Size

Size of Main

Repaired - New Service W.O. #4526 Valeri #531

Location

JAN 22 1973

Date	Material	Amount	Total	Date		Amount
5-22-67	33' 6" Transite pipe			5-2-67	Deposited	100.00
	10' 4" Cast Iron pipe			1-22-68	Paid by WHCH#15	12.47
				11-29-68	Paid	14.20
5/15/67	Labor	42.56				126.67
	"	<u>21.69</u>	64.25	8-22-68		4.20
	10% O.H.	<u>6.43</u>	70.68			130.87
	15' 6" Transite pipe @ .88		13.20			
	1 6" Elbow		4.09			
	3' 8" Clay pipe @ .70		2.10			
	1 Bag Cement		1.55			
	3 Hrs. Trucking @ 3.00		9.00			
	3½ Hrs. Shovel @ 6.50		22.75			
	1½ Hrs. Compressor @ 5.00		7.50	6-10-73	Solids	
			130.87			
						18.75


DATE _____

TOWN OF LEXINGTON — BOARD OF PUBLIC WORKS

SEWER DIVISION

Sketch of Service Here

17

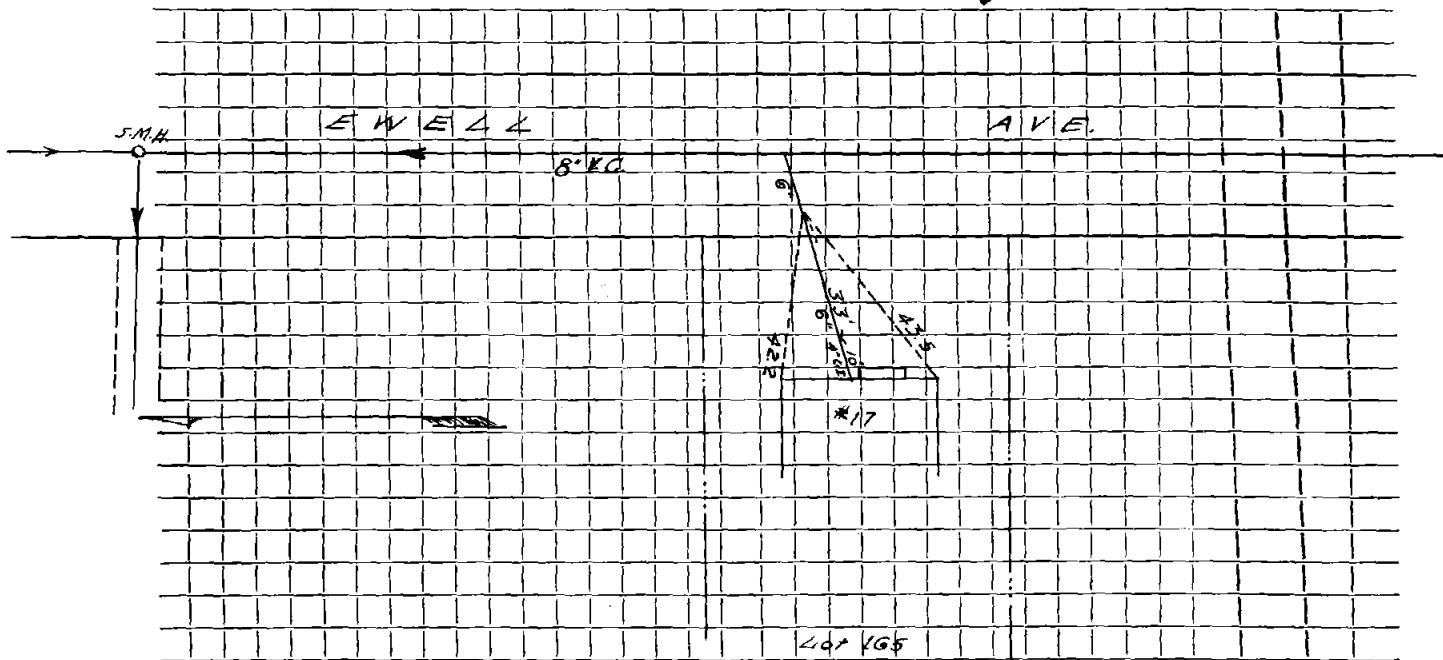

Connection made in Street. Work completed

Remarks:

.....

.....