


DATE _____

TOWN OF LEXINGTON — BOARD OF PUBLIC WORKS
SEWER DIVISION

Sketch of Service Here

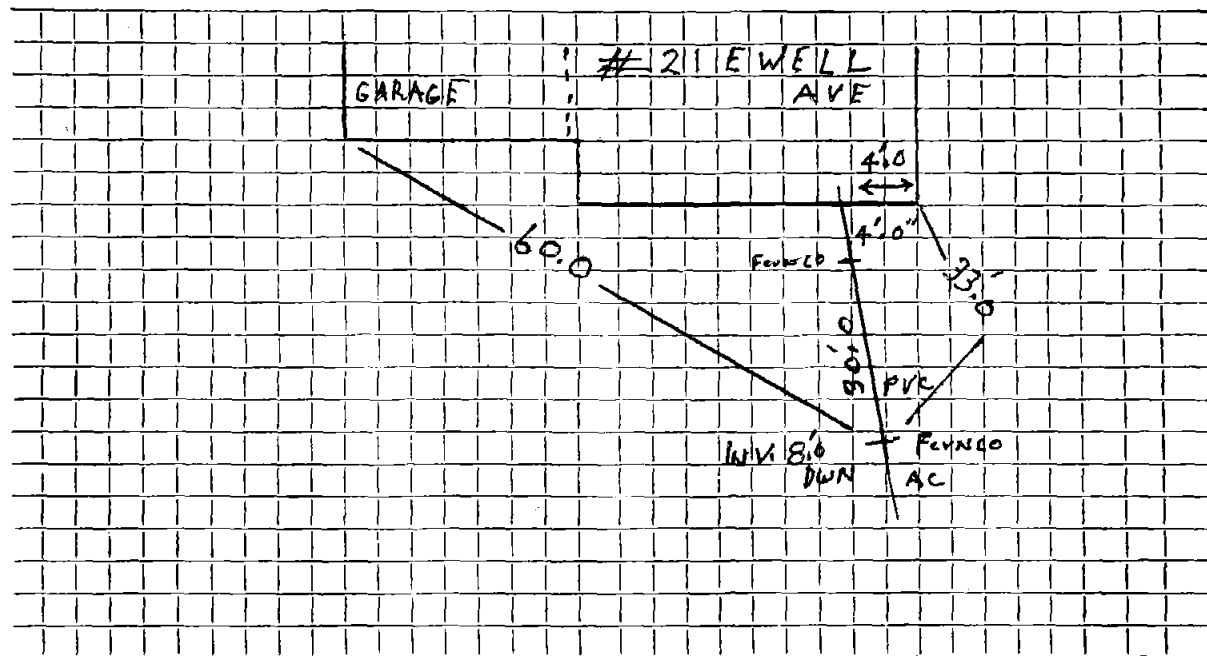

Connection made in Street.

Work completed 3/23/05 J. McLaughlin

Remarks:
.....
.....