


DATE 2 NOVEMBER 1995

TOWN OF LEXINGTON — BOARD OF PUBLIC WORKS
SEWER DIVISION

Sketch of Service Here **28**

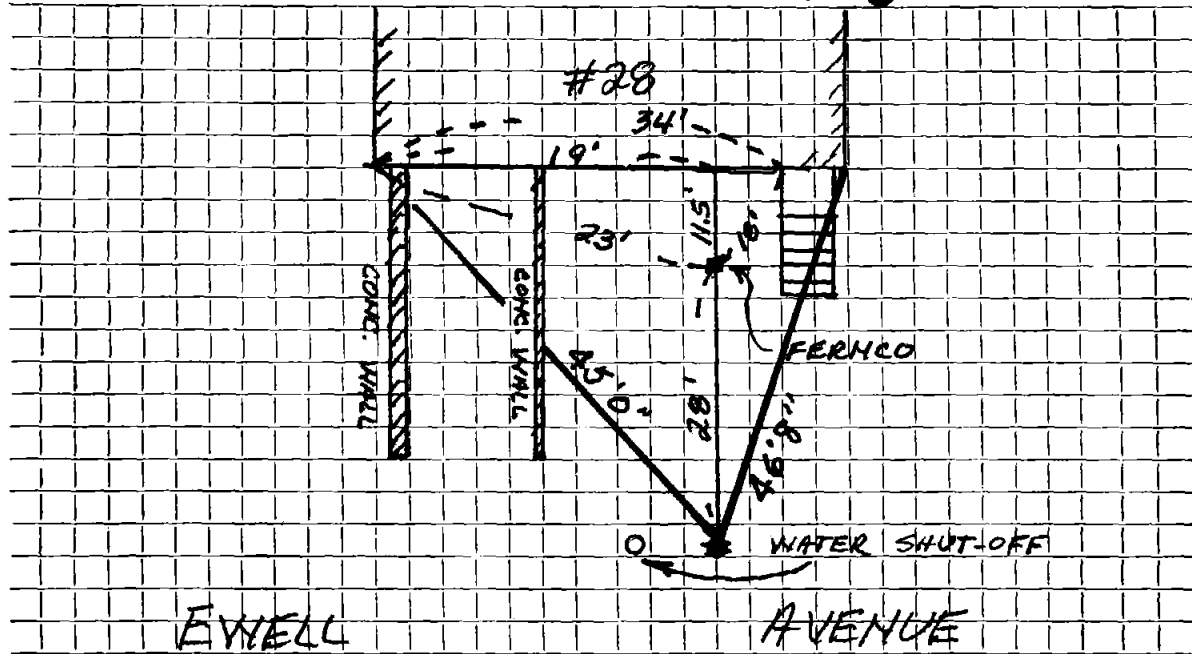

Connection made in EWELL AVENUE Street.

Work completed ARLEX OIL COMPANY

Remarks: