


DATE _____

TOWN OF LEXINGTON — BOARD OF PUBLIC WORKS

SEWER DIVISION

Sketch of Service Here

3

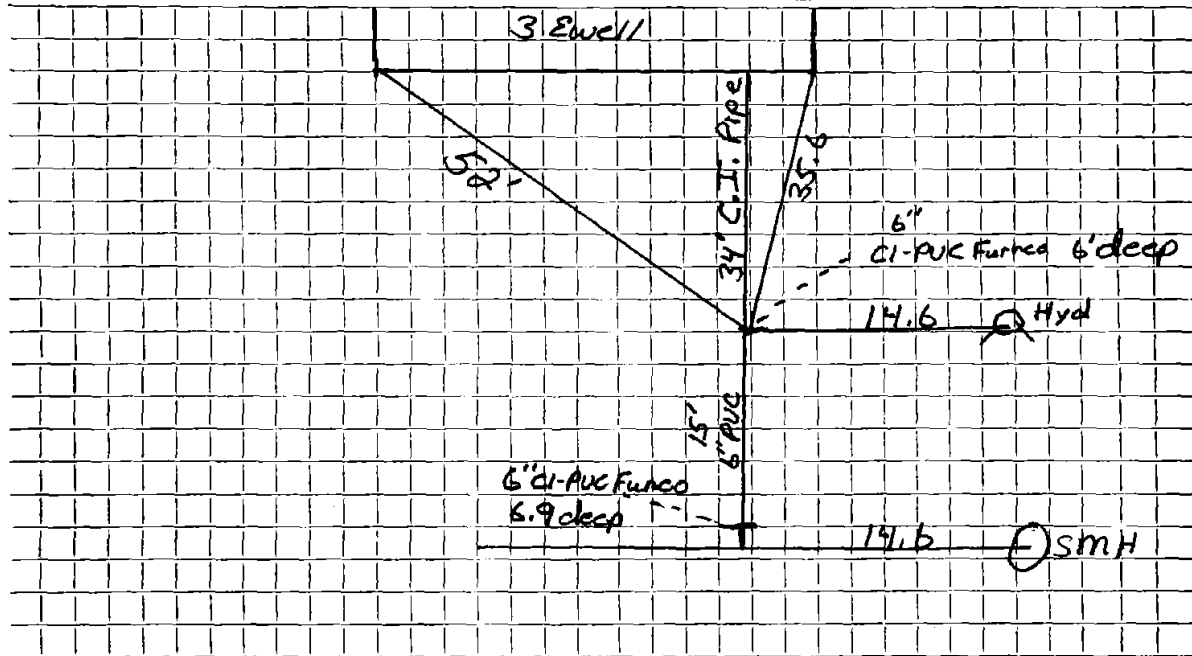

Connection made in Street. Work completed ... 5-8-91

Remarks:
.....
.....