


TOWN OF LEXINGTON — BOARD OF PUBLIC WORKS

SEWER DIVISION

DATE 7/13/71

Sketch of Service Here

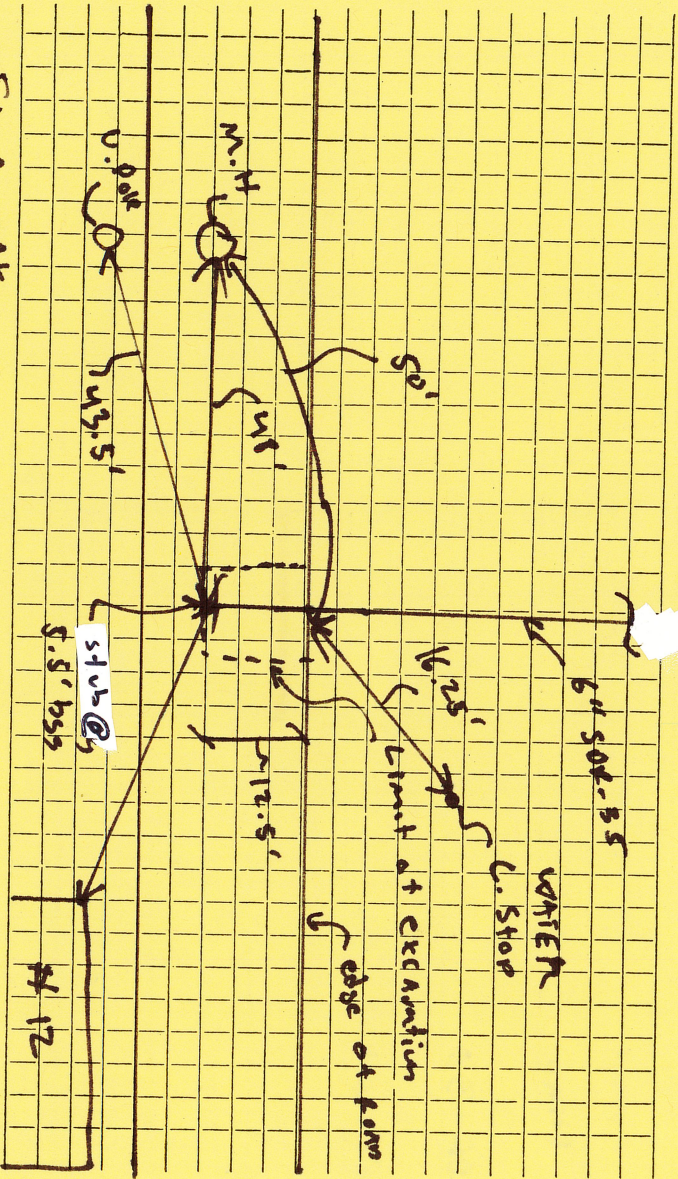

Connection made in FAIR DR'S Street. Work completed

Remarks: * Allowed Installer to leave existing

clay WYE b/c in good shape & did not

want to ruin/disturb existing 8" clay line.

