

Name Dianne Estates, Inc.

Service No. 176

Address 17 Fair Oaks Terrace DRIVE

Location

Comm. 2-16-59

Kind of Pipe

Size

Size of Main

~~Repair - Renewal~~ — New Service

Location

Date	Material	Amount	Total	Date	Amount
10/23/58	Labor	54 59		10/21/58	Deposit \$ 200 00
	10% overhead	5 46	60 05	2/16/59	Refund * <u>164 93</u>
	86' - 6" Transite pipe @ .70		60 20		\$ 135 07
	1 - 11 1/4" Transite bend		5 10		
	2 - 22 1/2" Transite elbows @ 2.24		6 72		
	8x3 Patch		8 00		
	3 hrs. Pippin Backhoe @ 4.50		13 50		
	2 hrs. Trucking @ .75		1 50		\$ 1.75
			135 07		* Applied w. H.C. #220
	Labor				

Name Dianne Estates, Inc.

Service No. 176

Address 17 Fair Oaks Terrace DRIVE

Location Comm. 2-16-59

Kind of Pipe

Size

Size of Main

~~Repair~~ ~~Renewal~~ ~~New Service~~

Location

Date	Material	Amount	Total	Date	Amount
10/23/58	Labor	54 59		10/21/58	Deposit \$ 200 00
	10% overhead	5 46	60 05	2/16/59	Refund * 164 93
	86' - 6" Transite pipe @ .70		60 20		\$ 135 07
	1 - 11 $\frac{1}{4}$ " ⁰ Transite bend		5 10		
	2 - 22 $\frac{1}{2}$ " ⁰ Transite elbows @ 2.24		6 72		
	8x3 Patch		8 00		
	3 hrs. Pippin Backhoe @ 4.50		13 50		
	2 hrs. Trucking @ .75		1 50		
			135 07		\$ 1.75
					* Applied w. H. C. #220
	Labor				

TOWN OF LEXINGTON—DEPT. OF PUBLIC WORKS
SEWER DIVISION

DATE.....

NO.


The undersigned applies for the construction of a particular sewer connecting No.....
Street and hereby agrees to comply with the Rules and Regulations governing the construction and use of Particular
Sewers, as now or at any future time established by the Board of Selectmen.

Am't of estimate \$.

Am't Paid \$.

..... Owner

Sketch of Service Here

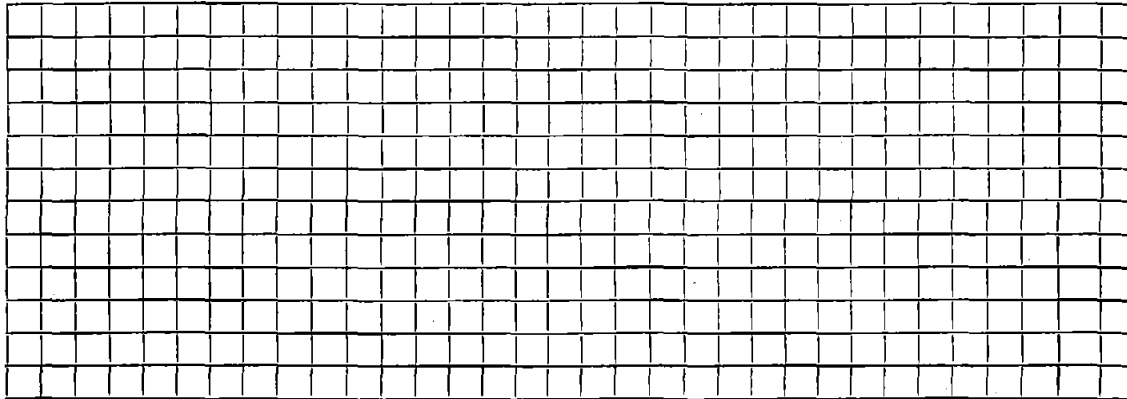

Connection made in..... Street.

Work completed..... 19..

Remarks: