


DATE 10-19-90

TOWN OF LEXINGTON — BOARD OF PUBLIC WORKS
SEWER DIVISION

24 Sketch of Service Here

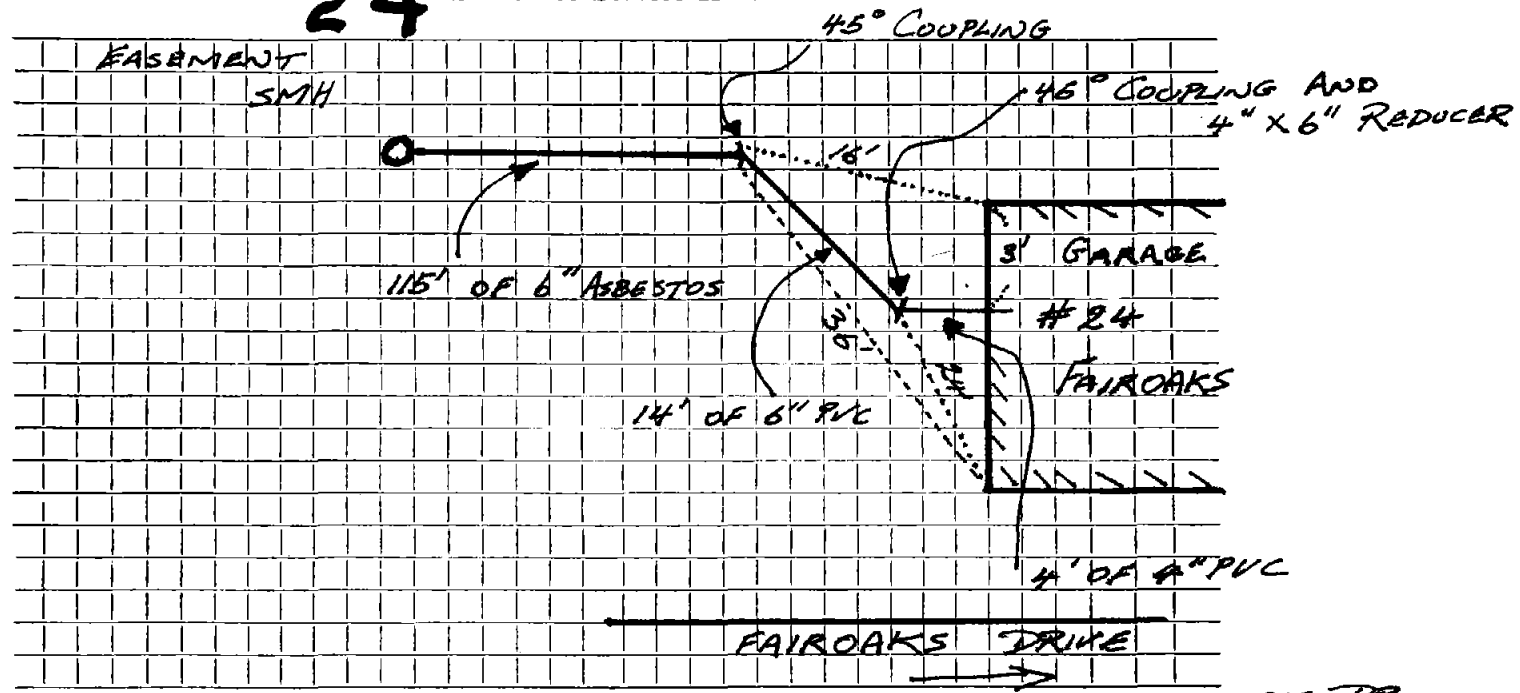

Connection made in ... FAIROAKS DRIVE ... ~~SEWER~~ Work completed ... TO OUTLOOK DR.

Remarks: INSPECTED 10-11-90 BY P. BARROWS, CONSTRUCTION BY E. BANKS
NO OUTSIDE TIES