

Name William Schwarz

Service No. 104

Address 25 Fair Oaks Drive

Location

Kind of Pipe

Size

Size of Main

~~REPAIR~~ ~~RENEWAL~~ — New Service

COM. 9-6-55

Location

Date	Material	Amount	Total	Date	Amount
7/6/55	Labor	34 54		6-1-55	250 00
7/7/55	"	50 50	85 04	9-6-55	(2 52)
	10% overhead		8 50		247 48
	125' - 6" sewer pipe @ .32		40 00		
	1 - 6" elbow		1 88		
	patching 10 x 3		10 00		
	joint compound		7 56		
	6 hrs. trucking @ .75		4 50		
	12 hrs. Littlefield shovel @ 7.50		90 00		
			247 48		
	Labor				
				2-7-66	ROTTED PIPE AT CURB
				4-11-66	Slits in pipe

TOWN OF LEXINGTON—DEPT. OF PUBLIC WORKS
SEWER DIVISION

DATE

NO.


The undersigned applies for the construction of a particular sewer connecting No.
Street and hereby agrees to comply with the Rules and Regulations governing the construction and use of Particular
Sewers, as now or at any future time established by the Board of Selectmen.

Am't of estimate \$.

Am't Paid \$.

..... Owner

Sketch of Service Here **25**

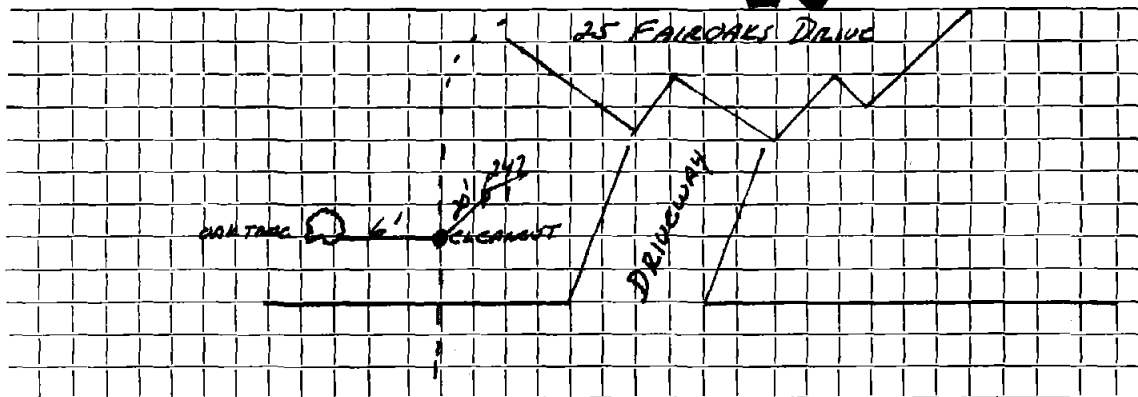

Connection made in Street.

Work completed 19..

Remarks: