

Name **Medill Bair**

Service No. **70**

Address **40 Fair Oaks Drive**

Location

Kind of Pipe

Size

Size of Main

~~XXXXXXXXXX~~ **N** New Service

Location **Comm 7-17-61**

Date	Material	Amount	Total	Date	Amount
6-14-61	Labo <del>OR</del> 70.37			6-6-61	200.00
6-15-61	Labo <del>OR</del> 8.12			7-17-61	5.31
6-20-61	Labo <del>OR</del> 10.83	89.32			194.69
	10% <del>O</del> .H.	8.93	98.25		
	48' 6" <del>TR</del> ansite pipe @.78		37.44		
	1 90° <del>TR</del> ansite pipe		5.40		
	1 11 1/4° <del>TR</del> ansite Band		5.10		
	14 <del>K</del> 3 Patch		14.00		
	3 Hrs. <del>T</del> own Shovel @6.50		19.50		
	4 Hrs. <del>TR</del> ucking @3.00		12.00		
	1 Hr. <del>LO</del> ader @3.00		3.00		
			<u>194.69</u>		


DATE \_\_\_\_\_

TOWN OF LEXINGTON — BOARD OF PUBLIC WORKS

SEWER DIVISION

Sketch of Service Here

40

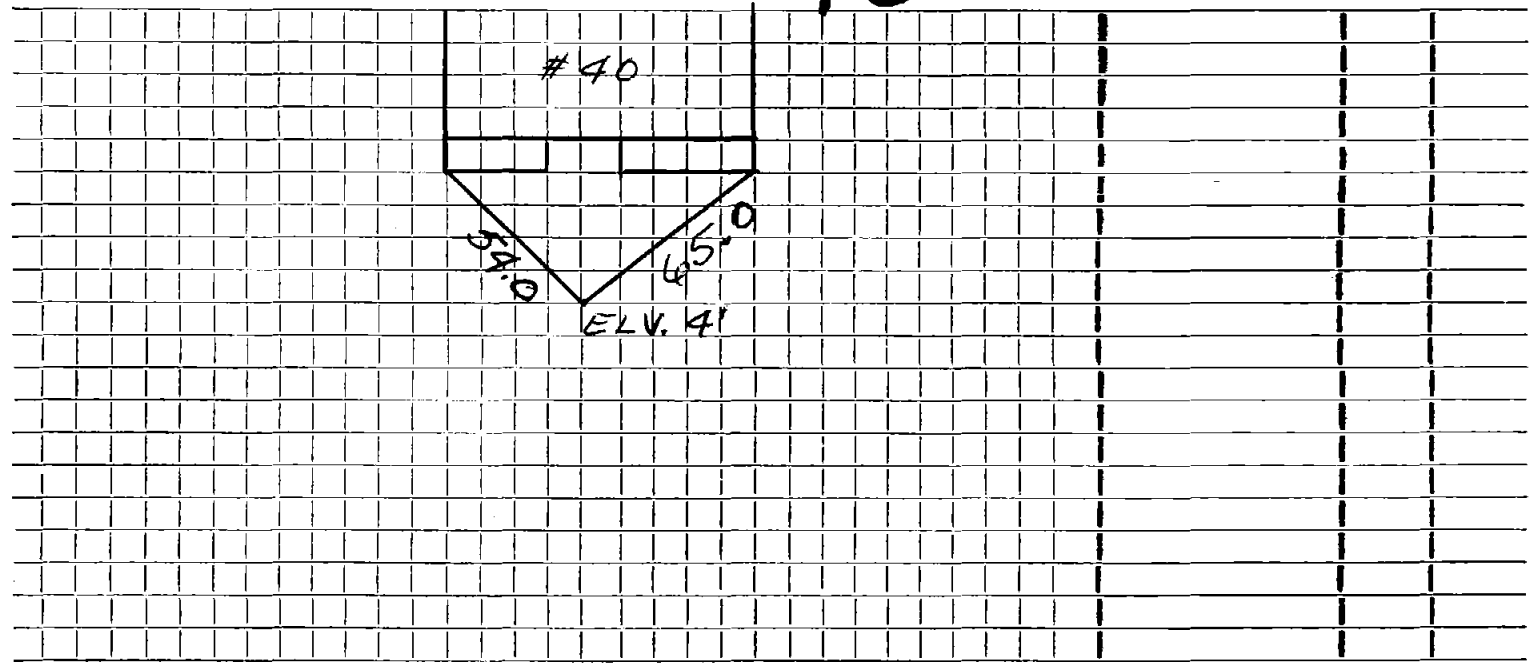

Connection made in ..... Street. Work completed .....

Remarks: .....  
.....  
.....